


Section 5 Township 14 Range 15-W

Well No. 33- C. A. Mermis

Company Stanolind

NORTH

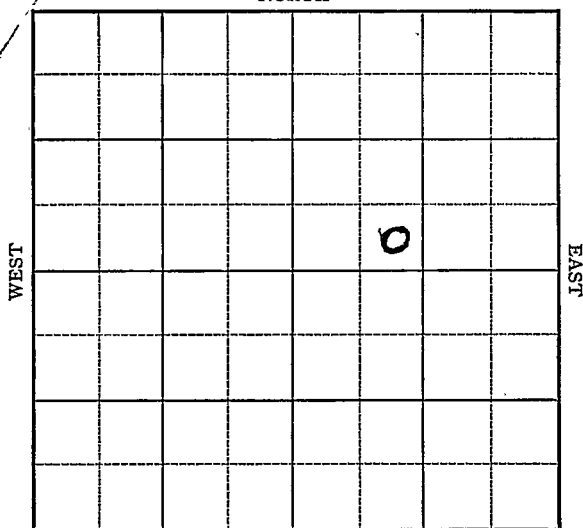


SOUTH

2

Sec. 5 Twp. 14 R. 15-WWell No. #33 C.A. Mermis Farm
Stanolind Company Ft. from N. Line330 Ft. from S. Line Ft. from E. Line990 Ft. from W. Line

Elev. 1895

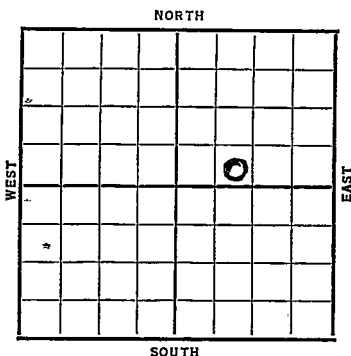

Date	REPORT
1937	
8/4	Material
8/13	B. R.
8/20	"
8/28	16" @ 38'. Drlg. 4958.
9/3	13" @ 558'. Anhy 9h2'.
	10" @ 920'. Drlg. 1400'.
9/10	Drlg. 2345'.
9/17	8" @ 2508'. Drlg. 2583'.
9/24	8" @ 2720'. S.O. 2774-79'.
	Fishing 2859'.
10/2	7" @ 2850'. Drlg. 2960'.
10/8	7" @ 3038'. Oswald 3048'.
	Drlg. 3050'. No shows.
10/15	Oswald 3043' (Corrected)
	7" @ 3047'. SDa3052-55'.
	T.D. 3097'. Swb'g.
	OVER

1937

10/20 7" @ 3047'.

Oswald 3043' (Corrected)

T.D. 3079'.

3000 acid.

Potential 625 bbls.

COMPLETED .

Map No. _____ Sec. 5 Twp. 14 R. 15^wWell No. 53 - C. A. MervisStanaland Company

Contractor _____

FIRST REPORT

_____ Ft. from N. Line

330 Ft. from S. Line

_____ Ft. from E. Line

990 Ft. from W. Line

SECTION PLAT

		o	

Location _____

Rig up _____

Drilling and Remarks:

material

RECORD

Cased _____ in., _____ ft.

Sand _____

Gas _____

Oil _____

Total Depth _____

PRODUCTION

1st 24 hrs. Nat. _____

1st 24 hrs. after shot _____

Gas _____ Cu. Ft.

Dry Hole _____

Abandoned _____

Date

AUG 4 - 1937 19H. D. Hatfield Scout.

Russell

KANSAS

Map No. _____ Sec. 5 Twp. 14 R. 15WWell No. 33 C A MermisStanolind Company

Contractor

COMPLETED

SE SW NE

_____ Ft. from N. Line

330 Ft. from S. Line

_____ Ft. from E. Line

990 Ft. from W. Line**SECTION PLAT**

		0	

Location _____

Rig up _____

Drilling and Remarks:

3000 Acid
POT-625

RECORDCased 7 in., 3047 ft.Sand Oswald 3043Gas (Corrected)

Oil _____

Total Depth 3079**PRODUCTION**

1st 24 hrs. Nat. _____

1st 24 hrs. after shot _____

Gas _____ Cu. Ft.

Dry Hole _____

Abandoned _____

Date

OCT 20 1937 19H. D. Hatfield Scout