


Section 5 Township 14 Range 15W

Well Number #36 C.A. Mermis

Company Stanolind

NORTH

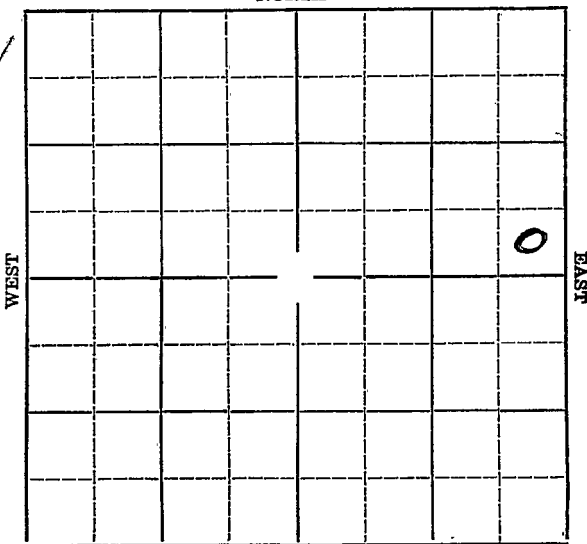

SOUTH

Map No. KANSAS Sec. 5 Twp. 14 R. 15W

Well No. #36 C.A. Mermis Farm


Stanolind Company

_____ Ft. from N. Line

330' Ft. from S. Line

330' Ft. from E. Line

_____ Ft. from W. Line

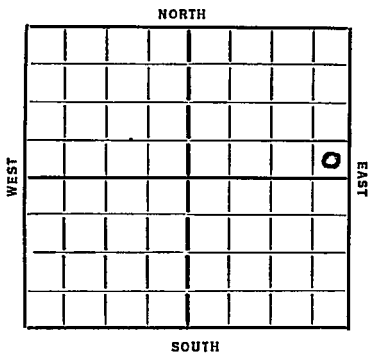

Elev. 1894

1936

REPORT

- 5/20 Location.
- 5/28 Building rig.
- 6/4 Rigging up.
- 6/11 Spud 125'.
- 6/18 Drlg. 690'.
- 6/25 Drlg. 1180'.
- 7/2 Drlg. 2090'.
- 7/9 Under reaming 8" to 2510'.
- 7/16 8" @ 2513'. Drlg. 2580'.
- 7/23 Lansing 3041'. Show of oil 3041-44'
Under ream 7".
- 7/30 Pay 3065-75'. 1000' oil in 1½ hrs.
Total depth 3077'.
- 8/6 T.D. 3078'. Swabbed 125 bbls in 3 h
hours after head. 3000 gallons of
acid. No test.
- 8/12/36-Lansing 3041'.
Pay 3065-75'.
TD 3078'. 3000 gallons of acid.
Potential 548 bbls of oil

COMPLETED

Map No. 72 Sec. 5 Twp. 14 R. 15W

Well No. 36 C A Mervis

Standard Company

Contractor

SECTION PLAT

			0

_____ Ft. from N. Line

330 Ft. from S. Line

330 Ft. from E. Line

_____ Ft. from W. Line

FIRST REPORT

Location ✓

Rig up _____

Drilling and Remarks:

RECORD

Cased _____ in., _____ ft.

Sand _____

Gas _____

Oil _____

Total Depth _____

PRODUCTION

1st 24 hrs. Nat. _____

1st 24 hrs. after shot _____

Gas _____ Cu. Ft.

Dry Hole _____

Abandoned _____

Date

MAY 20 1936

19

S. J. LEWIS

Scout

KANSAS

Form 26-1M Bks-2-29

Map No. 72 Sec. 5 Twp. 14 R. 15W

Well No. 36 Nermis

Standard Company

Contractor

SECTION PLAT

			0

_____ Ft. from N. Line

330 Ft. from S. Line

880 Ft. from E. Line

_____ Ft. from W. Line

COMPLETED

Location _____

Rig up _____

Drilling and Remarks:

Leasing 3041
Pay 2065-75
3000 aced
P 8 548

RECORD

Cased _____ in., _____ ft.

Sand _____

Gas _____

Oil _____

Total Depth 3075

PRODUCTION

1st 24 hrs. Nat. _____

1st 24 hrs. after shot _____

Gas _____ Cu. Ft.

Dry Hole _____

Abandoned _____

Date

AUG 12 1936 19

S. J. LEWIS Scout