



Russell

FORM 252A-5M-12-28-PETROL

Map No. **KANSAS** Sec. 5 Twp. 14 R. 15<sup>w</sup>

Well No. 22-Portland Farm


Midwest Company

\_\_\_\_\_ Ft. from N. Line

990 Ft. from S. Line

330 Ft. from E. Line

\_\_\_\_\_ Ft. from W. Line

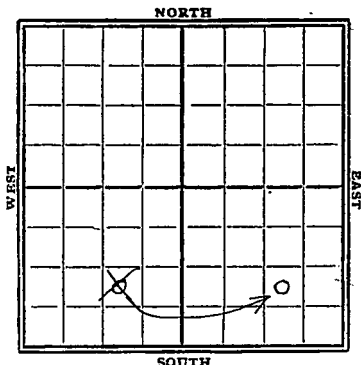

1929

Date	REPORT
1/23	Rog
1/30	Rig
2/6	—
2/13	—
2/20	Reynier
2/27	Spud
3/6	Only 550'
3/13	" 1185' 10"-922'
3/20	" 2110'
3/27	" 2845' 8"-2814'
4/3	no report
4/10	Oswald sand 3046-96 T.D. 3096'
	Pump 30 bbl oil 5 amp.

*Russell*

MAP NO. MINNACAS SEC. 5 TWP. 14 R. 15W

WELL NO. 22 *Don Hand*

*Mid West* COMPANY

CONTRACTOR

**SECTION PLAT**

	0		

\_\_\_\_\_ FT. FROM N. LINE

990 FT. FROM S. LINE

330 FT. FROM E. LINE

\_\_\_\_\_ FT. FROM W. LINE

**FIRST REPORTS**

LOCATION \_\_\_\_\_

RIG UP \_\_\_\_\_

DRILLING AND REMARKS:

*ROG*

**RECORD**

CASED \_\_\_\_\_ IN. \_\_\_\_\_ FT.

SAND \_\_\_\_\_

GAS \_\_\_\_\_

OIL \_\_\_\_\_

TOTAL DEPTH \_\_\_\_\_

**PRODUCTION**

1ST 24 HRS. NAT. \_\_\_\_\_

1ST 24 HRS. AFTER SHOT \_\_\_\_\_

GAS \_\_\_\_\_ CU. FT.

DRY HOLE \_\_\_\_\_

ABANDONED \_\_\_\_\_

DATE

**JAN 23 1929**

192

**S. J. LEWIS**

SCOUT

*Russell*

MAP NO. KANSAS SEC. 5 TWP. 14 R. 13 W

WELL NO. 22 Doe Hand

Mich. West COMPANY

CONTRACTOR

SECTION PLAT

			0

\_\_\_\_\_ FT. FROM N. LINE

990 FT. FROM S. LINE

330 FT. FROM E. LINE

\_\_\_\_\_ FT. FROM W. LINE

CORRECTION

LOCATION \_\_\_\_\_

RIG UP \_\_\_\_\_

DRILLING AND REMARKS:

*Reported  
Nov. 8 E. 80'*

RECORD

CASED \_\_\_\_\_ IN. \_\_\_\_\_ FT.

SAND \_\_\_\_\_

GAS \_\_\_\_\_

OIL \_\_\_\_\_

TOTAL DEPTH: \_\_\_\_\_

PRODUCTION

1ST 24 HRS. NAT. \_\_\_\_\_

1ST 24 HRS. AFTER SHOT<sup>2</sup> \_\_\_\_\_

GAS \_\_\_\_\_ CU. FT.

DRY HOLE \_\_\_\_\_

ABANDONED \_\_\_\_\_

DATE

**FEB 6 1929**

*S. J. LEWIS*

Map No. **KANSAS** Sec. 5 Twp. 14 R. 15W

Well No. 22 Doe stand

Mid West Company

Contractor

**SECTION PLAT**

			0

..... Ft. from N. Line

990 Ft. from S. Line

990 Ft. from E. Line

..... Ft. from W. Line

**COMPLETED**

Location.....

Rig up.....

Drilling and Remarks:

*Oswald Sand  
3046 & 3096*

*Pump 3084*

**RECORD**

Cased..... in., ..... ft.

Sand.....

Gas.....

Oil.....

Total Depth 3096

**PRODUCTION**

1st 24 hrs. Nat.....

1st 24 hrs. after shot.....

Gas..... Cu. Ft.

Dry Hole.....

Abandoned.....

Date

**APR 10 1929**

192.....

**S. J. LEWIS**

Scout