


Map No. KANSAS Sec. 5 Twp. 14 R. 15^w
Well No. 36-Portland Farm _____
Mid West Company _____

NORTH

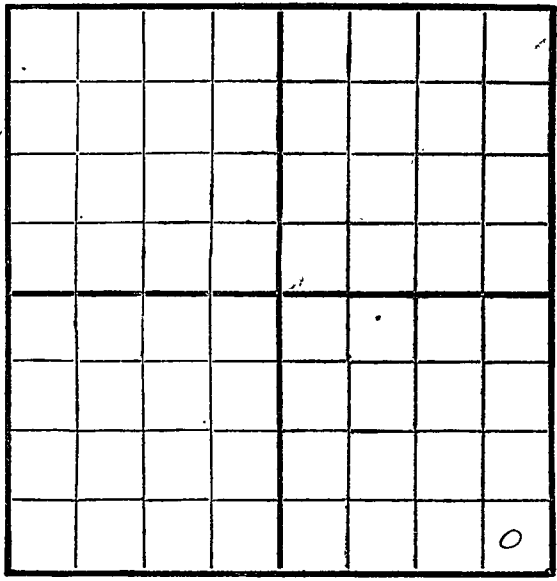

SOUTH

Location _____

Drilling Remarks _____

Rig Up _____

Drilling Remarks _____

RECORD

Cased _____ in. _____ ft.
Sand _____
Gas _____
Oil _____
Total Depth _____

PRODUCTION


1st 24 hrs. Nat. _____
1st 24 hrs. after shot _____
Gas _____ cu. ft. _____
Dry Hole _____
Abandoned _____

Russell

Map No. **KANSAS** Sec. 5 Twp. 14 R. 15^w

Well No. 36- Portland Farm
Mid West Company

_____ Ft. from N. Line
330 Ft. from S. Line
330 Ft. from E. Line
_____ Ft. from W. Line

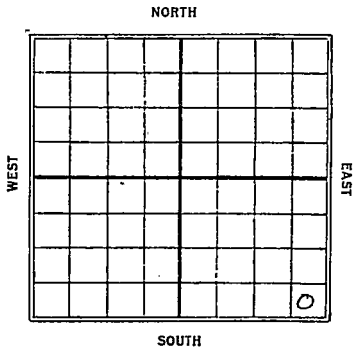

1930

Date	REPORT
<u>2/5</u>	<u>Pellat</u>
<u>2/12</u>	<u>—</u>
<u>2/19</u>	<u>P.O.L.</u>
<u>2/26</u>	<u>Rig.</u>
<u>3/5</u>	<u>—</u>
<u>3/12</u>	<u>Spud 310</u>
<u>3/19</u>	<u>Outg. 810'</u>
<u>3/26</u>	<u>" 1410'</u>
<u>4/2</u>	<u>" 2200'</u>
<u>4/9</u>	<u>" 2570'</u>
<u>4/16</u>	<u>" 2820-10"-2760</u>
<u>4/23</u>	<u>Top Oswald sand</u> <u>3037 oil 3065-67</u> <u>T.D. 3101 Swab</u> <u>40 bbls.</u>
<u>4/30</u>	<u>Sand 3037-3103</u> <u>TD 3103</u> <u>Swab 40 bbl oil</u> <u>@ 40° gas</u> <u>Comp.</u>

Map No. **KANSAS** Sec. 5 Twp. 17 R. 15W

Well No. 72 36 The Hand

Mid-West Company

Contractor

SECTION PLAT

.....Ft. from N. Line

330 Ft. from S. Line

330 Ft. from E. Line

.....Ft. from W. Line

FIRST RIGHTS

Location.....

Rig up.....

Drilling and Remarks:

Cellar

RECORD

Cased..... in.,ft.

Sand.....

Gas.....

Oil.....

Total Depth.....

PRODUCTION

1st 24 hrs. Nat.....

1st 24 hrs. after shot.....

Gas..... Cu. Ft.

Dry Hole.....

Abandoned.....

Date

FEB 3 1931

S. J. LEWIS

Scout

Russell
 Map No. **KANSAS** Sec. 5 Twp. 14 R. 15W
72
 Well No. 36 Dothman

Mid. Kan. & Co. Company
 Contractor

SECTION PLAT

..... Ft. from N. Line
330 Ft. from S. Line
330 Ft. from E. Line
 Ft. from W. Line

COMPLETED

Location.....
 Rig up.....
 Drilling and Remarks:

*Swab & 40 ft. h
 40% gravity*

RECORD

Cased..... in., ft.
 Sand: 2037 - 2103
 Gas.....
 Oil.....
 Total Depth 2103

PRODUCTION

1st 24 hrs. Nat.....
 1st 24 hrs. after shot.....
 Gas..... Cu. Ft.
 Dry Hole.....
 Abandoned.....

Date

APR 30 1930₁₉₂ S. J. LEWIS Scout