


Section 5 Township 14 Range 15-W

Well Number 34 Mermis

Company Stanolind

NORTH

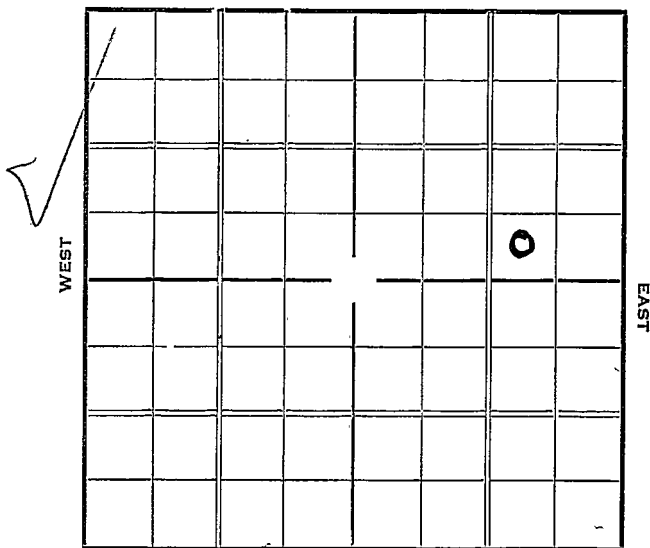


WEST

EAST

SOUTH

Sec. 5 Twp. 14 R. 15-WWell No. #34 Mermis FarmStanolind Company         Ft. from N. Line330 Ft. from S. Line990 Ft. from E. Line         Ft. from W. Line

Elev. 1894

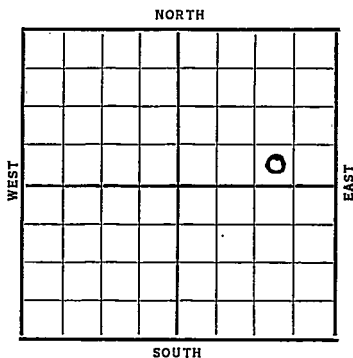

Date	REPORT
1937	
5/19	Ponds
5/28	Tig'n up cable tools.
6/4	15" @ 33'. 12" @ 566'. Drlg. 585'.
6/11	Anhy. 924'. Drlg. 1630'.
6/19	10" @ 925'. Drlg. 2370'.
6/25	Drlg. 2595'.
7/2	8" @ 2594'. Drlg. 2610'.
7/9	8" @ 2739'. Topeka 2765'. S.O. 2840'. S.W. 2860-65'. Drlg. 2945'.
7/16	Lansing 3037'. 7" @ 3040'. T.D. 3070'. 600' oil 3 hrs. Will acidize.
7/21	Lans 3037' 7" @ 3040' TD 3075' 3000 acid Pot 506 <b>COMPLETED</b>

Russell KANSAS

Map No. 72 Sec. 5 Twp. 14 R. 15<sup>w</sup>Well No. 34-MermisStanlind Company

Contractor

## FIRST REPORT

## SECTION PLAT

       Ft. from N. Line330 Ft. from S. Line990 Ft. from E. Line       Ft. from W. Line

			0

Location       Rig up       

Drilling and Remarks:

Ponds

## RECORD

Cased        in.,        ft.Sand       Gas       Oil       Total Depth       

## PRODUCTION

1st 24 hrs. Nat.       1st 24 hrs. after shot       Gas        Cu. Ft.Dry Hole       Abandoned       

Date

MAY 19 1937H. D. Hatfield

Scout

*Russell*

Map No. 72 Sec. 5 Twp. 14 R. 15<sup>w</sup>

Well No. 34-Mervis

Stanolind Company

Contractor

**COMPLETED**

**SECTION PLAT**

\_\_\_\_\_ Ft. from N. Line  
330 Ft. from S. Line  
990 Ft. from E. Line  
 \_\_\_\_\_ Ft. from W. Line

			0

Location \_\_\_\_\_

**RECORD**

Rig up \_\_\_\_\_

Cased 7 in., 3040 ft.

Drilling and Remarks:

Sand Lans-3037

Gas \_\_\_\_\_

Oil \_\_\_\_\_

Total Depth 3075

*3000 Acid*

**PRODUCTION**

*Pat - 506*

1st 24 hrs. Nat. \_\_\_\_\_

1st 24 hrs. after shot \_\_\_\_\_

Gas \_\_\_\_\_ Cu. Ft.

Dry Hole \_\_\_\_\_

Abandoned \_\_\_\_\_

Date

JUL 21 1937 19 H. D. Hatfield Scout