


Form 51-5M-5-34-Palace

Map No. KANSAS Sec. 9 Twp. 14 R. 13

Well No. #6 C.A. Merrick Farm

Company

NORTH

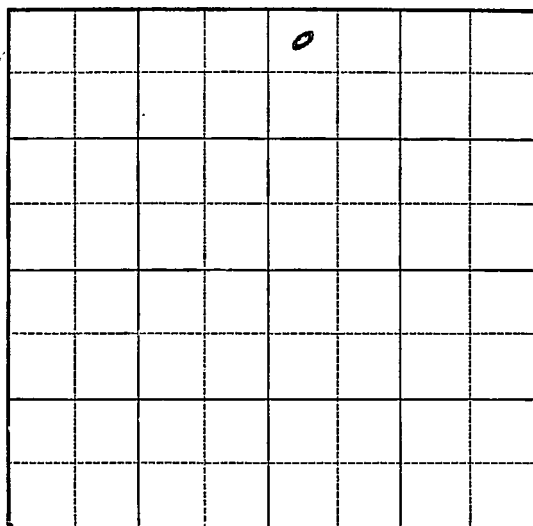

SOUTH

Location_____

Drilling Remarks

Rig Up

Drilling Remarks

RECORD

Cased_____in._____ft.

Sand_____

Gas_____

Oil_____

Total Depth_____

PRODUCTION

1st 24 hrs. Nat. _____

1st 24 hrs. after shot-----

Gas _____cu. ft._____

Dry Hole-----

Abandoned-----

Russell

Map No. KANSAS Sec. 5 Twp. 14 R. 15W


Well No. 6 C. A. Mermis Farm
Stanolind Company

330 Ft. from N. Line

_____ Ft. from S. Line

_____ Ft. from E. Line

330 Ft. from W. Line

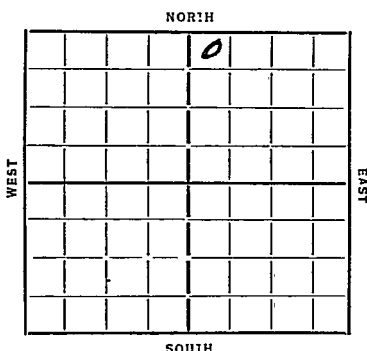

Date 1935 REPORT

<u>1/9</u>	<u>Location</u>	
<u>1/17</u>	<u>B. R.</u>	
<u>1/24</u>	<u>_____</u>	
<u>1/31</u>	<u>Rgn.</u>	
<u>2/7</u>	<u>Qty 475</u>	<u>15" 390</u>
<u>2/14</u>	<u>" 1250</u>	<u>10" 938</u>
<u>2/21</u>	<u>" 2200</u>	
<u>2/28</u>	<u>8" 2574 C.O.</u>	
<u>3/7</u>	<u>2600 seg</u>	
<u>3/14</u>	<u>Qty 2738</u>	<u>8" 2580</u>
<u>3/21</u>	<u>Oswald 3031 6" 3072 WOC</u>	<u>3129</u>
<u>3/28</u>	<u>Sat core 3090-93 PB 3146</u>	
<u>4/4</u>	<u>3141 1/2 T7 Corrected</u>	
	<u>PB 3129 1000 acid</u>	
<u>4/10</u>	<u>Oswald 3031 T7 3141 1/2</u>	
	<u>PB 3129 1000 acid</u>	
	<u>72 oil & 23 w.</u>	

COMPLETED

Map No. 72 Sec. 5 Twp. 14 R. 15WWell No. 6. C. A. MermisStanplind Company

Contractor

SECTION PLAT

FIRST REPORTS

330 Ft. from N. Line

Ft. from S. Line

Ft. from E. Line

330 Ft. from W. Line

		0	

Location ✓

Rig up

Drilling and Remarks:

RECORD

Cased in., ft.

Sand

Gas

Oil

Total Depth

PRODUCTION

1st 24 hrs. Nat.

1st 24 hrs. after shot

Gas Cu. Ft.

Dry Hole

Abandoned

Date

1-9-35

192

ORVAL MANNSCHRECK

Scout

Map No. 72 Sec. 5 Twp. 14 R. 15Well No. 6-C. G. MermisStanolind Oil Company

Contractor

COMPLETED

SECTION PLAT

330 Ft. from N. Line

Ft. from S. Line

Ft. from E. Line

330 Ft. from W. Line

		0	

Location

Rig up

Drilling and Remarks:

P. B. 3129
1000 and
72 oil
23 w

RECORD

Cased in ft.

Sand Oswall 3031

Gas

Oil

Total Depth 3141 1/2

PRODUCTION

1st 24 hrs. Nat.

1st 24 hrs. after shot

Gas Cu. Ft.

Dry Hole

Abandoned

Date

ORVAL MANNSCHRECK

4-10-35 192 Scout