


Section 6 Township 14 Range 30N

Well No. #1 Benson

Company Westgate-Greenland  
Wildcat

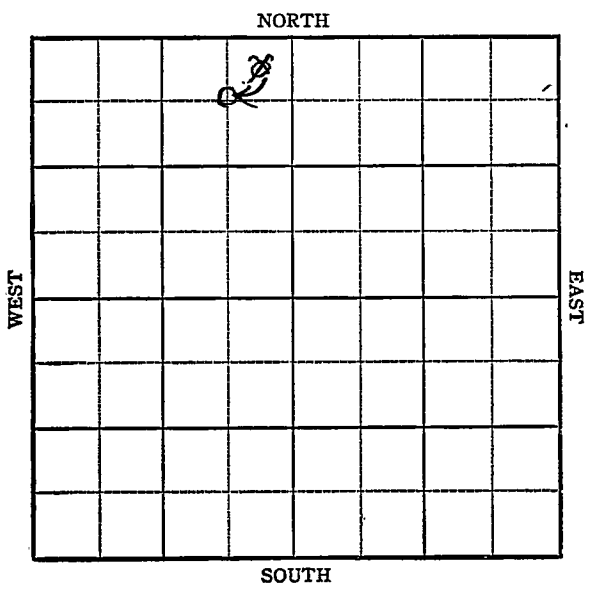

Sec. 6 Twp. 14 R. 30-W

Well No. #1 Benson Farm

Westgate-Greenland Company

Wildcat

660'

~~330~~ Ft. from N. Line


Ft. from S. Line

660'

~~330~~ Ft. from E. Line

Ft. from W. Line

C NE NW

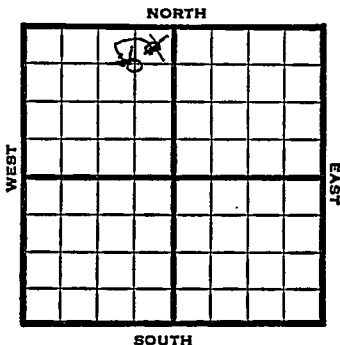

1948

Eli 2741'

REPORT

10/13

Location

10/19

"

10/26

13" @ 85

Drlg 2790'

11/3

Lansing 3842'

Drlg. 3898'

11/10

Drlg. 4556'

11/16

Miss 4560'

Arb 4897

Drlg. 4927'

11/23

TD 4946'

Miss 4562'

Arb 4888'

Aband.

**ABANDONED**

Map No. \_\_\_\_\_ Sec. 6 Twp. 14 R. 30W

Well No. 1 Benson

Westgate-Greenland

Company

**FIRST REPORT**

Contractor

NE NW

**SECTION PLAT**

330 Ft. from N. Line

\_\_\_\_\_ Ft. from S. Line

330 Ft. from E. Line

\_\_\_\_\_ Ft. from W. Line

	o		

Gove County

**RECORD**

Location X

Rig up \_\_\_\_\_

Drilling and Remarks:

Cased \_\_\_\_\_ in., \_\_\_\_\_ ft.

Sand \_\_\_\_\_

Gas \_\_\_\_\_

Oil \_\_\_\_\_

Total Depth \_\_\_\_\_

**PRODUCTION**

1st 24 hrs. Nat. \_\_\_\_\_

1st 24 hrs. after shot \_\_\_\_\_

Gas \_\_\_\_\_ Cu. Ft.

Dry Hole \_\_\_\_\_

Abandoned \_\_\_\_\_

Date

OCT 13 1948 19

S. J. LEWIS

Scout

Map No. \_\_\_\_\_ Sec. 6 Twp. 14 R. 30W

Well No. 1 Benson

Westgate - Greenland Company

**ABANDONED**

Contractor

C NE NW

*E1, 2741*

**SECTION PLAT**

660 Ft. from N. Line

\_\_\_\_\_ Ft. from S. Line

660 Ft. from E. Line

\_\_\_\_\_ Ft. from W. Line

	o		

Gove County

Location \_\_\_\_\_

Rig up \_\_\_\_\_

Drilling and Remarks:

*Mis 4562*

*Cor 4888*

**RECORD**

Cased \_\_\_\_\_ in., \_\_\_\_\_ ft.

Sand \_\_\_\_\_

Gas \_\_\_\_\_

Oil \_\_\_\_\_

Total Depth 4946

**PRODUCTION**

1st 24 hrs. Nat. \_\_\_\_\_

1st 24 hrs. after shot \_\_\_\_\_

Gas \_\_\_\_\_ Cu. Ft.

Dry Hole \_\_\_\_\_

Abandoned \_\_\_\_\_

Date

NOV 23 1948 19

S. J. LEWIS Scout

Map No. \_\_\_\_\_ Sec. 6 Twp. 14 R. 30W

Well No. 1 Benson

Westgate-Greenland Company

**CORRECTION**

Contractor

C NE NW

**SECTION PLAT**

660 Ft. from N. Line

\_\_\_\_\_ Ft. from S. Line

660 Ft. from E. Line

\_\_\_\_\_ Ft. from W. Line

	o		
		.	

Gove County

Location \_\_\_\_\_

Rig up \_\_\_\_\_

Drilling and Remarks:

Reported  
NE NW

**RECORD**

Cased \_\_\_\_\_ in., \_\_\_\_\_ ft.

Sand \_\_\_\_\_

Gas \_\_\_\_\_

Oil \_\_\_\_\_

Total Depth \_\_\_\_\_

**PRODUCTION**

1st 24 hrs. Nat. \_\_\_\_\_

1st 24 hrs. after shot \_\_\_\_\_

Gas \_\_\_\_\_ Cu. Ft.

Dry Hole \_\_\_\_\_

Abandoned \_\_\_\_\_

Date

NOV 17 1948 19

S. J. LEWIS

Scout