


Ellis KANSAS

SECTION 6 TOWNSHIP 14S RANGE 16W

WELL NO. #1 Dreiling

COMPANY Buick Drlg. Co.

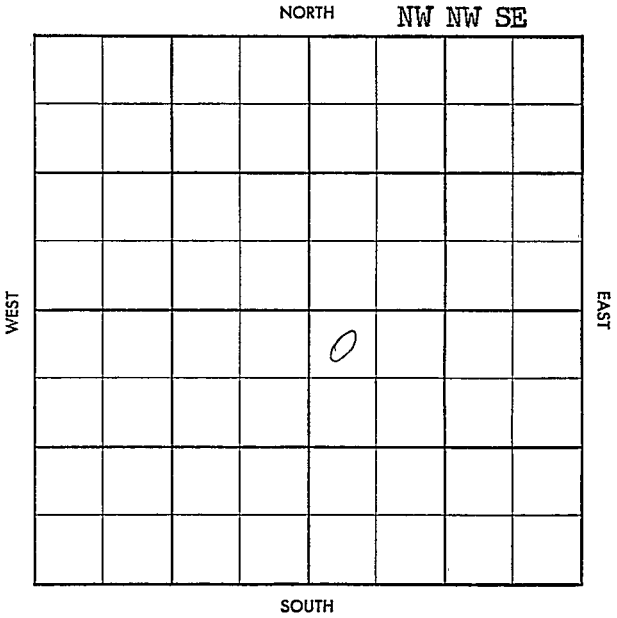



Twp.  Pool   
 Co.  Facet

5-513-B

County Ellis Elev. 11' 135' 100'  
 Sec. 6 Twp. 14 Rge. 16W  
 Company Buick Drlg. Co.  
 Farm Name Dreiling No. 1

TOPS	DEPTH	LOG	DATUM
Anh.			
Tp.			
H.	<u>3175</u>		
Tr.			
Dg.			
B.L.			
E.	<u>3220</u>		
K.C.			
B.K.C.	<u>3412</u>		
Co.			
C. <u>Cherty</u>	<u>3466</u>		
M.			
M.			
K.			
Mz.			
Mq.			
V.			
S.			
A. <u>W heater</u>	<u>3479</u>		
<del>P.</del> <u>Arb</u>	<u>3494</u>		
P.			
G.			
T.D.	<u>3502</u>		

Loc. in Sec. NW NW SE  
 Geol.         
 Contr.         
 Co. Tools         
 Pool Victoria  
 No. Ext.       

**ABANDONED**  
 0  
 MAY 21 '58

Date Comp. 5-9-58  
 WBT 811 @ 226 w/135, w/spudder WORT. APR 9 '58  
 APR 18 '58 APR 23 '58 SD. APR 30 '58 MAY 7 '58  
 MAY 14 '58 2791 MAY 21 '58 no log

D610

Co. Sec. No. T. R.