


Section 6 Township 14 Range 16 W

Well No. # 1 Dreiling

Company Victor Drlg. & Deep Rock

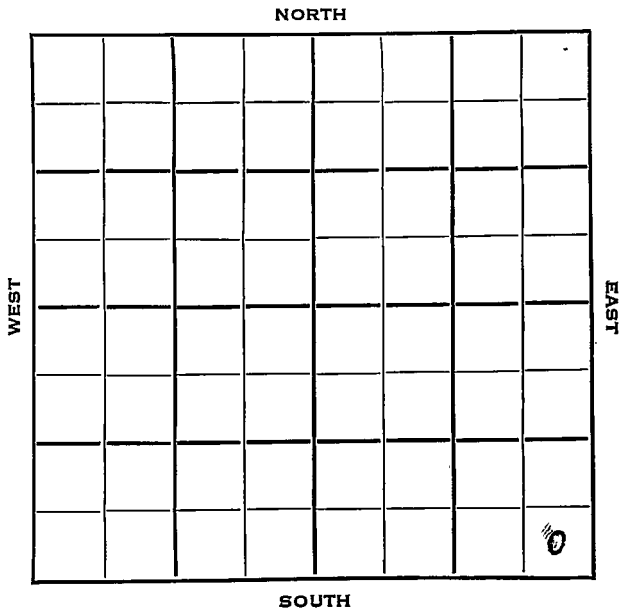

Ellis

KANSAS ✓

Sec. 6 Twp. 14 R. 16W

Well No. #1 Dreiling Farm

Victor Drlg. & Deep Rock Company

Wildcat Contractor


         Ft. from N. Line

330 Ft. from S. Line

330 Ft. from E. Line

         Ft. from W. Line

SE SE SE

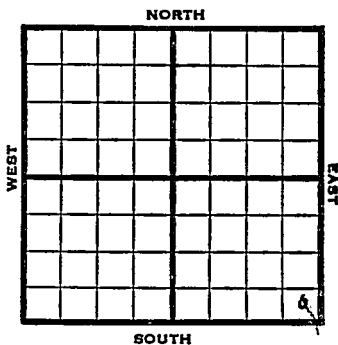

1952 Elev. 1954' REPORT

11/26 Location

12/4 8" @ 158

12/11 Heeb 3178 Tor 3197 Lans 3222 Ø 3239

12/18 Cong 3462 ARB 3471 RTD 2480 DST 3472-80 3 Hrs. 225 gas 130' free oil 225' muddy oil 550# 5" @ 3472 Schl Co 3480 S/3½ BOPH 1st Hr. S/1 BOPH after 9 Hrs. 500A S/2½ BOPH

12/25 " " " "

1/1 POP

1/8 NR

1/22 NR

1/28 Spud 11-30-52

Oil Well

TD 3480

8" @ 158

Heeb 3178, Tor 3197, Lans 3222,

Cong 3462, Arb. 3471

TD 3480

DST 3472-80, opn 3 hrs., rec.

225' gas, 130' free oil, 125'

muddy oil, 550#

5" @ 3472,

CO to 3480, S/3½ boph S/1 boph

500A B/2½ boph 750A P/1¼ boph

OVER

#1 Dreiling  
(Information Brought Forward)

1953  
1/28

63% wtr.

Comp. 9 bopd 70% wtr.

**COMPLETED**



Scout Cards	.....
Land Small Map	.....
Land Wall Map	.....
Tracings	.....
France Map	.....
Pierce Mao	.....
Misc.	.....

*10*

NOV 28 1952

*3*

County Ellis State Kansas

Sec. 6 (Blk. Twp.) 14 (Sur. Rge.) 16W Map No.

Operator Victor Drlg. & Deep Rock

Well No. 1 Farm Dreiling

Elev. 1954 Location SE SE SE

					0

330 Ft. From S Line SE

330 Ft. From E Line Quarter

1st. Report

Completion JAN 28 1953

Remarks Wildcat

Spudding Date 11-30-52

Drlg. Data Oil well TD 3480

8" @ 158 Heeb. 3178 Tor. 3197

Lans. 3222 Cong. 3462 Arb. 3471

TD 3480 DST 3472-80 open 3 hr.

Rec. 225' gas 130' free oil 125' muddy

oil 550# 5" @ 3472 CO to 3480

S/ 3 1/2 boph S/ 1 boph 500 A B/ 2 1/2 boph

750 A P/ 14 bopd 63% wtr.

Comp. 9 bopd 70% wtr.

Scout Cards	
Land Small Map	
Land Wall Map	35
Tracings	
France Map	
Pierce Map	
Misc.	

FEB 4 1953

Dirig. Data