

Section 6 Township 14 Range 15W

Well No. 1 Foster-Aley

Company Phil-Han

Gorham

NORTH

							0

WEST

EAST

SOUTH

✓

✓

KANSAS

Russell



Sec. 6 Twp. 14 R. 15W

Well No. #1 Foster-Aley Farm

Phil-Han Company

Gorham Pool


_____ Ft. from N. Line

330' Ft. from S. Line

330' Ft. from E. Line

_____ Ft. from W. Line

SE NE

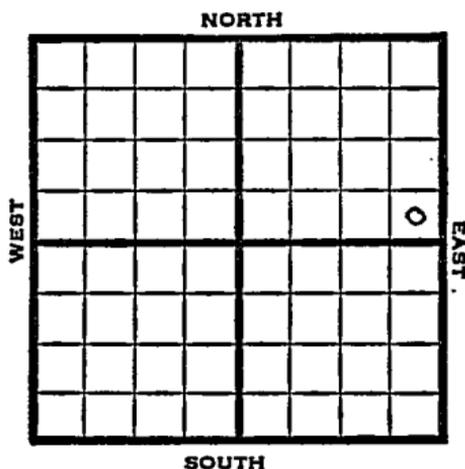

1949

Elev 1874' REPORT

- 2/2 Location
- 2/9 Location
- 2/16 8" @ 208'
- 2/23 Drlg 2630'
- TD 3383'
- Lans. 3036'
- Granite 3387'
- Aband.

ABANDONED

Kansas

15^W

Map No. _____ Sec. 6 Twp. 14 R. _____

Well No. 1 Foster - Aley

Phil-Han

Company

FIRST REPORT

Contractor

SE NE

SECTION PLAT

_____ Ft. from N. Line

330 _____ Ft. from S. Line

330 _____ Ft. from E. Line

_____ Ft. from W. Line

Russell County

Location _____ X

Rig up _____

Drilling and Remarks:

RECORD

Cased _____ in., _____ ft.

Sand _____

Gas _____

Oil _____

Total Depth _____

PRODUCTION

1st 24 hrs. Nat. _____

1st 24 hrs. after shot _____

Gas _____ Cu. Ft.

Dry Hole _____

Abandoned _____

Date

FEB 2 1949 19

S. J. LEWIS Scout

