


Russell
14 R. 15^W

Map No. KANSAS Sec. 6 Twp. 14 R. 15^W

Well No. A. J. Polcyn Farm _____
L. D. Davidson etc Company _____

NORTH

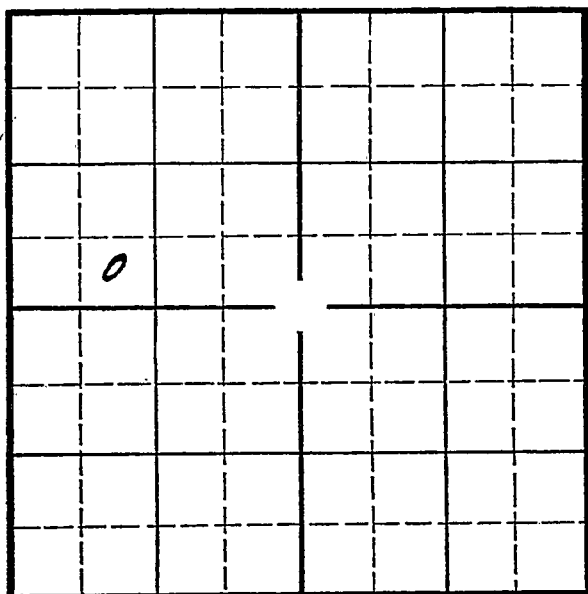

SOUTH

Location _____
Drilling Remarks _____

Rig Up _____
Drilling Remarks _____

RECORD

Cased _____ in. _____ ft.
Sand _____
Gas _____
Oil _____
Total Depth _____

PRODUCTION

1st 24 hrs. Nat. _____
1st 24 hrs. after shot _____
Gas _____ cu. ft.
Dry Hole _____
Abandoned _____

Russell
14 R. 15^w

KANSAS

Map No. _____ Sec. 6 Twp. _____ R. _____


Well No. 1 - Polcyn Farm _____
L. D. Davidson et al Company _____

_____ Ft. from N. Line

330 Ft. from S. Line

_____ Ft. from E. Line

990 Ft. from W. Line

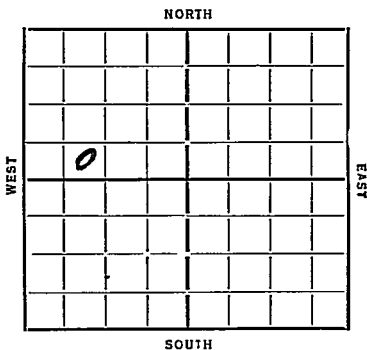

Date

REPORT

1935
10/24 Rig up.
11/11 delg 310
11/7 10" 9.65
11/14 delg 2375 8" 2598
11/21 " 3030 6" 2986
11/29 Top overhaul 3110
6 Barrels Water 3130-40
delg 3270
12/4 del 3435
TD 3434

D. & F.

ABANDONED

Map No. 72 Sec. 6 Twp. 14 R. 15W

Well No. 1- Polcyn

L. D. Davidsson et al Company

Contractor

FIRST REPORTS

SECTION PLAT

0			

Ft. from N. Line

330 Ft. from S. Line

Ft. from E. Line

990 Ft. from W. Line

Location.....

Rig up

Drilling and Remarks:

RECORD

Cased.....in.,ft.

Sand.....

Gas.....

Oil.....

Total Depth.....

PRODUCTION

1st 24 hrs. Nat.....

1st 24 hrs. after shot.....

Gas.....Cu. Ft.

Dry Hole.....

Abandoned.....

Date

10-24-35 192.....

ORVAL MANNSCHRECK

Scout

KANSAS

Map No. 72 Sec. 6 Twp. 14 R. 15W

Well No. 1 - Polcyon
L. D. Wardson et al Company

Contractor

ABANDONED

SECTION PLAT

0			

Ft. from N. Line

330 Ft. from S. Line

Ft. from E. Line

990 Ft. from W. Line

RECORD

Location.....

Cased..... in., ft.

Rig up.....

Sand oil 3425

Drilling and Remarks:

Gas.....

Oil.....

Total Depth 3434

10 + F1

PRODUCTION

1st 24 hrs. Nat.....

1st 24 hrs. after shot.....

Gas..... Cu. Ft.

Dry Hole.....

Abandoned.....

Date

ORVAL WINTSCH

12-4-35 192..... Scout