

Cellsworth
FORM 252A-24-6-30-PETROL

Map No. **KANSAS** Sec. 7 Twp. 14 R. 7^w

Well No. 1-Union Pacific RR Farm

Gurley & Barnsdall company


330 Ft. from N. Line

_____ Ft. from S. Line

_____ Ft. from E. Line

330 Ft. from W. Line

1932

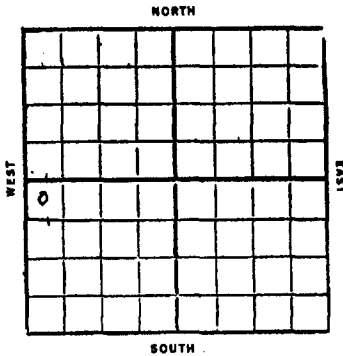

- 11/16- HFW 2670' Ring 8"
- 11/23- 8"-2670
dreg 2780'
- 11/30- 8" hanging 2785
dreg 2860'
- 12/7- 8"-2849
HFW 2930' dreg on
- 12/14- SD 3073'
- 12/21- TD 3078' UIR 8"
- 12/28- 8"-2990
dreg 3170'

- 1933
- 1/3- Top Cong. 3308
6"-3329 SD
- 1/11- Correction - 3330 = 3334
6"-3358
1 bailer water 3406-10
6 " " 3514-17
TD 3517 UIR 6"
- 1/18- Top Cong. 3308
6"-3514
Viola 3514-3601
HFW 3590-95
TD 3601
Abandoned

Date	REPORT
7/13	Loc
7/20	—
7/27	—
8/3	Rig
8/10	dreg water well
8/17	—
8/24	Regn up
8/31	SD 335 for water
9/7	15"-1300 dreg 600'
9/14	" 740'
9/21	15"-457 12"-740
	SD 755
9/30	SD 1030'
10/5	SD 1075 for water
10/12	SD 1350'
10/17	SD 1375 for water
10/26	dreg 1800'
11/2	Ring 10"-2135'
11/9	10"-2140
	SD 2245 repairs

Ellsworth

53 KANSAS
Map No. Sec. 7 Twp. 14 R. 7 W
Well No. 1 Union Pac RR
Gurley & Barnsdall Company
Contractor

FIRST REPORTS

SECTION PLAT

330 Ft. from N. Line
Ft. from S. Line
Ft. from E. Line
330 Ft. from W. Line


Ellsworth

53 KANSAS
Map No. Sec. 7 Twp. 14 R. 7 W
Well No. 1 Union Pac RR
Gurley & Barnsdall Company
Contractor

COMPLETED

SECTION PLAT

330 Ft. from N. Line
Ft. from S. Line
Ft. from E. Line
330 Ft. from W. Line


ABANDONED

Location ✓
Rig up
Drilling and Remarks:

RECORD
Cased in, ft.
Sand
Gas
Oil
Total Depth

PRODUCTION
1st 24 hrs. Nat.
1st 24 hrs. after shot
Gas Cu. Ft.
Dry Hole
Abandoned

Location
Rig up
Drilling and Remarks:

RECORD
Cased in, ft.
Sand
Gas
Oil
Total Depth 3601

Top Log 3308
6" 3514
Viola 3514-3601
HFW 3590-95

PRODUCTION
1st 24 hrs. Nat.
1st 24 hrs. after shot
Gas Cu. Ft.
Dry Hole ✓
Abandoned ✓

Date JUL 18 1932 CHAS. L. SHERWOOD Scout

Date JAN 18 1933 CHAS. L. SHERWOOD Scout

