

Section 7 Township 14 Range 16W

Well No. #1 Quint

Company United Drlg.

NORTH

							0

SOUTH

WEST

EAST

KANSAS

Sec. 7 Twp. 11 R. 16W

Well No. #1 Quint Farm

United Drlg. Company

United Drlg. Contractor

Victoria Pool


330 Ft. from N. Line

 Ft. from S. Line

330 Ft. from E. Line

 Ft. from W. Line

NE NE NE

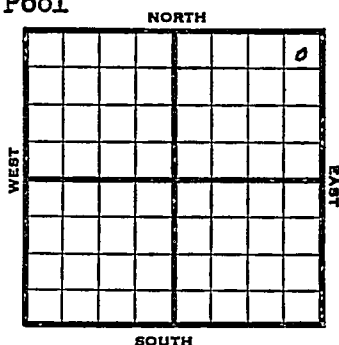

1953 Elev. 1949' REPORT

8/19 Spud 8-15-53
8" @ 200'
Drlg 1450'

8/26 Drlg 3375'

9/2 Spud 8-15-53
D&A
TD 3505
8" @ 200'
Top 2953, Heeb 3170, Dodge 3188',
Lans 3212, ReArb. 3456
DST 3469-80, opn 1 hr., rec. 3' mud
TD 3505
D&A

ABANDONED

J. G. McGEHEE

