

Form 26-1M Bks. 2-29 **KANSAS**

Map No. 52 Sec. 36 Twp. 14 R. 8W.

Well No. 1 Dolecheck

Cy Frost & Co. Company
Contractor

SECTION PLAT

330 Ft. from N. Line

_____ Ft. from S. Line

330 Ft. from E. Line

_____ Ft. from W. Line

FIRST REPORT

Location _____

Rig up _____

Drilling and Remarks:

Rig

RECORD

Cased _____ in., _____ ft.

Sand _____

Gas _____

Oil _____

Total Depth _____

PRODUCTION

1st 24 hrs. Nat. _____

1st 24 hrs. after shot _____

Gas _____ Cu. Ft.

Dry Hole _____

Abandoned _____

Date

JAN 6 1937

19

S. J. LEWIS Scout

Form 26-1M Bks. 2-29 **KANSAS**

Map No. 53 Sec. 36 Twp. 14 R. 8W.

Well No. 1 Dolecheck

Frost, Miller & Co. Company
Contractor

SECTION PLAT

660 Ft. from N. Line

_____ Ft. from S. Line

660 Ft. from E. Line

_____ Ft. from W. Line

CORRECTION

Location _____

Rig up _____

Drilling and Remarks:

*Reported NE
BN.*

RECORD

Cased _____ in., _____ ft.

Sand _____

Gas _____

Oil _____

Total Depth _____

PRODUCTION

1st 24 hrs. Nat. _____

1st 24 hrs. after shot _____

Gas _____ Cu. Ft.

Dry Hole _____

Abandoned _____

Date

JAN 27 1937

S. J. LEWIS

Scout

Ellsworth

Map No. *53* Sec. *36* Twp. *14* R. *8W*

Well No. *1 - Dolchick*

Frost, Miller, et al Company

Contractor

ABANDONED

660 Ft. from N. Line

70 Ft. from S. Line

660 Ft. from E. Line

_____ Ft. from W. Line

SECTION PLAT

	0		

Location _____

Rig up _____

Drilling and Remarks:

H.F.W.

DXA

Viola - 3376
RECORD
Simp 3445

Cased _____ in., _____ ft.

Sand *Si-3507*

Gas _____

Oil _____

Total Depth *3515*

PRODUCTION

1st 24 hrs. Nat. _____

1st 24 hrs. after shot _____

Gas _____ Cu. Ft.

Dry Hole _____

Abandoned _____

Date

JUN 2 1937 19 **H. D. Hatfield** Scout

Ellsworth
Form 252-A-5M-7-86-Palace **KANSAS**

Sec. 36 Twp. 14 R. 8-W

Well No. 1 Dolecheck Farm


Cy Frost et al Company

660
~~300~~ Ft. from N. Line

_____ Ft. from S. Line

660
~~300~~ Ft. from E. Line

_____ Ft. from W. Line

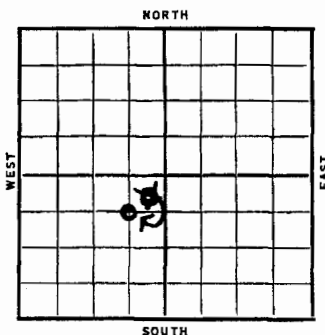

Elev. 1705

Date	REPORT
1937	
1/6	Rig
1/14	No report.
1/21	Rig & shut down.
1/28	" " "
2/4	" " "
2/11	Rigging up
2/19	Shut Down 300'
2/26	" " "
3/4	" " "
3/11	15" @ 195', 12" @ 352'.
	Anhydrate 570'. Drlg. 660'.
3/18	Drlg. 1055'.
3/25	Drlg. 1870'.
4/2	8" @ 1935'. T.D. 2005'
	Under ream 8"
4/8	" " " "
4/16	No report
4/23	2880' underream 8".
4/30	K. C. 2702'. 8" @ 2756'.
	T.D. 3020'. Rung. 6".
5/7	6" @ 3020'. T.D. 3308'.
	OVER

1937

5/14 6" @ 3020'.

T.D. 3308'.

5/21 Rn'g. 5".

5/28 5" @ 3348'. Drlg. 3386'.

6/2 Viola 3376'.

Simp. 3445'.

Sil. 3507'.

T.D. 3515'. H.F.W.

ABANDONED

KANSAS

Ellsworth

Section 36 Township 14 Range 8-W

Well Number 1 Dolecheck

Company Cy Frost et al

