


Section 8 Township 14 Range 16 W

Well No. # 1 Schulte

Company Victor Drlg.

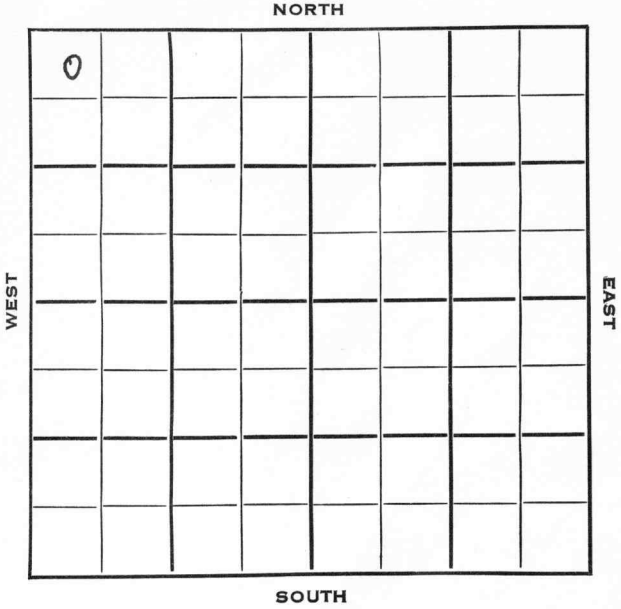

Sec. 8 Twp. 14 R. 16W

Well No. #1 Schulte Farm _____

Victor Drlg. Company _____

Victor Drlg. Contractor _____


330 Ft. from N. Line

_____ Ft. from S. Line

_____ Ft. from E. Line

330 Ft. from W. Line

NW NW NW

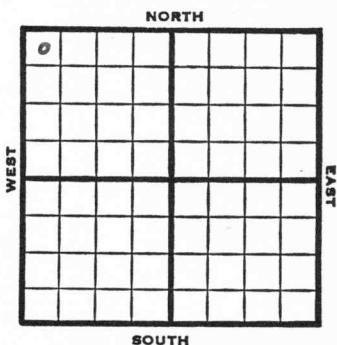

1953 Elev. 1949' REPORT

4/15 Location
 4/23 8" @ 172
 Anhy 1080
 Drlg. 2870'
 4/30 NR
 5/7 NR
 5/21 NR
 5/27 Spud 4-15-53
 Oil Well
 TD 3471'
 8" @ 172'
 Anhy 1080, Top 2948, Heeb 3163, Tor 3182
 DST 3184-96 opn 1 hr, rec 20' mud 50#
 Lans 3206
 DST 3235-40 opn 1 hr, rec 15' mud,
 Cong 3452, Arb 3457,
 DST 3459-66 opn 2 hr, rec 60' hocm,
 155' frothy oil, 150' gas, 810#
 DST 3467-71 opn 2 hr, rec 110' gas,
 130' mco, 920#
 TD 3471
 5" @ 3462'
 CO to 3471'
 B/ 2 boph 500 A

OVER

1953

Information brought forward.

5/27 B/ 2 boph 11 hr.
Comp. 30 bopd. 2% wtr.

COMPLETED

APR 17 1959

Scout Cards	AD
Land Small Map	
Land Wall Map	3
Tracings	
France Map	
Pierce Map	
Misc.	

County Ellis State Kansas
 Sec. 8 (Blk. 14 (Sur. 16W Map No.)
 Operator Victor Drlg.
 Well No. 1 Farm Schulte
 Elev. 1949 Location NW NW NW

Q					

330 Ft. From N Line NW
330 Ft. From W Line Quarter

1st. Report

Completion MAY 27 1953

Remarks

Victor Drlg. - Contr.

Spudding Date 4-15-53

Drlg. Data Oil well TD 3471

8" @ 172 Anhy 1080 Top. 2948

Heeb. 3163 Tor. 3182 DST 3184-96

open 1 hr. Rec. 20' mud 50#

Lans. 3206 DST 3235-40 open 1 hr.

Rec. 15' mud Cong. 3452 Arb. 3457

DST 3459-66 open 2 hr. Rec. 60' hocm

155' frothy oil 150' gas 810#

DST 3467-71 open 2 hr. Rec. 110' gas

130' mco 920# TD 3471 5" @ 3462

CO to 3471 B/ 1 boph 500 A

B/ 2 boph 11 hr.

Comp. 30 bopd 2% wtr.

J. G. McGEHEE

MAY 3 1953

Scout Cards	RP
and Small Map	
and Wall Map	33
Tracings	
Trance Map	
Trance Map	
Trance	