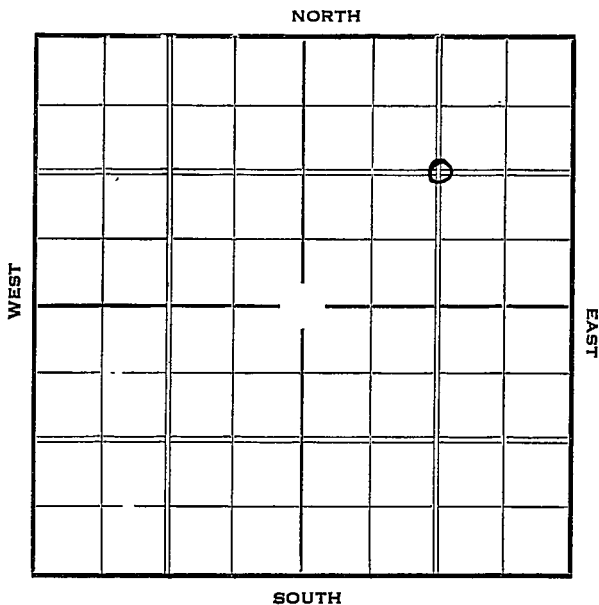



Russell

KANSAS

Section 8 Township 14 Range 15-WWell Number 3 DortlandCompany Bridgeport

Bridgeport Company

Elev. 1871

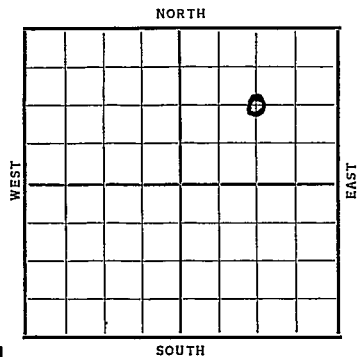[illegible]

Form 29 - 1st Ed. - 2-29 **KANSAS**

Map No. 72 Sec. 8 Twp. 14 R. 15W

Well No. 3 Portland

Bridgeport Company

J Contractor

SECTION PLAT

1320 Ft. from N. Line

_____ Ft. from S. Line

1320 Ft. from E. Line

_____ Ft. from W. Line

		2	

FIRST REPORT

Location _____

Rig up _____

Drilling and Remarks:

Spud 90'

RECORD

Cased _____ in., _____ ft.

Sand _____

Gas _____

Oil _____

Total Depth _____

PRODUCTION

1st 24 hrs. Nat. _____

1st 24 hrs. after shot _____

Gas _____ Cu. Ft.

Dry Hole _____

Abandoned _____

Date

JAN 6 1937

19

S. J. LEWIS Scout


Map No. 72 Sec. 8 Twp. 14 R. 15W

Well No. 3 Portland

Bridgeport Company

Contractor

SECTION PLAT

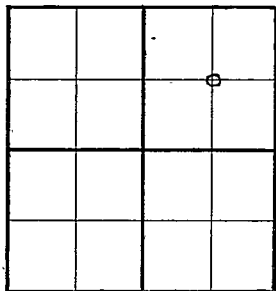

1320 Ft. from N. Line

_____ Ft. from S. Line

1320 Ft. from E. Line

_____ Ft. from W. Line

ABANDONED

Location _____

Rig up _____

Drilling and Remarks:

Lansing 3032.
Granite 3300

RECORD

Cased _____ in., _____ ft.

Sand _____

Gas _____

Oil _____

Total Depth 3306

PRODUCTION

1st 24 hrs. Nat. _____

1st 24 hrs. after shot _____

Gas _____ Cu. Ft.

Dry Hole ✓

Abandoned ✓

Date

MAR 3 1937

19

S. J. LEWIS Scout