


Map No. Russell KANSAS Sec. 8 Twp. 14 R. 15^w

Well No. 1 - Schwartz Farm

Allison-Fitzwilliams Company

NORTH

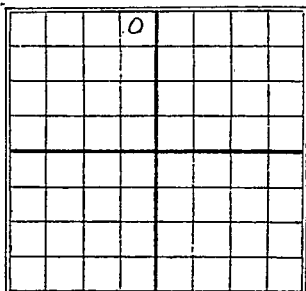

330 Ft. from N. Line

_____ Ft. from S. Line

330 Ft. from E. Line

_____ Ft. from W. Line

1930

Date	REPORT
7/2	Co L.
7/9	—
7/16	—
7/23	Rig up.
7/30	Shut down
8/6	hrlg. 425'
8/13	765'
8/20	12" - 920' dry 1215'
8/27	hrlg. 2050'
9/3	7325'
9/10	U/R 8" - 2770'
9/17	8" - 2775' dry
9/24	Top Oswald 3035
	6" - 3052
	show oil 3057-80
	dry ahead
10/1	9" 3160
10/8	Granite wash 3255-95
	TU 3295' HFW
	Abandon

Map No. KANSAS Sec. 8 Twp. 14 R. 15W

Well No. 72 1 Schwartz

Callison & Fitzwilliams Company
Contractor

SECTION PLAT

	0		

930 Ft. from N. Line
_____ Ft. from S. Line
320 Ft. from E. Line
_____ Ft. from W. Line

RECORDS

Location _____

Rig up _____

Drilling and Remarks:

ROG

RECORD

Cased _____ in., _____ ft.
Sand _____
Gas _____
Oil _____
Total Depth _____

PRODUCTION

1st 24 hrs. Nat. _____
1st 24 hrs. after shot _____
Gas _____ Cu. Ft.
Dry Hole _____
Abandoned _____

Date

JUL 2 1930

S. J. LEWIS

Scout

Map No. **KANSAS** Sec. 8 Twp. 14 R. 15W

Well No. 72 1 Schwarz

Callison & Fitzwilliam Company
Contractor

SECTION PLAT

320 Ft. from N. Line

..... Ft. from S. Line

330 Ft. from E. Line

..... Ft. from W. Line

	6		

ABANDONED

Location.....

Rig up.....

Drilling and Remarks:

Granite Jack
3255-95 NFW

RECORD

Cased..... in., ft.

Sand.....

Gas.....

Oil.....

Total Depth 3295

PRODUCTION

1st 24 hrs. Nat.....

1st 24 hrs. after shot.....

Gas..... Cu. Ft.

Dry Hole.....

Abandoned.....

Date

OCT 8 1930

S. J. LEWIS Scout