

Ellsworth


53 KANSAS Sec. 5 Twp. 14 R. 9 W

Well No. 1 Sarraw
Viking Oil Co. Company
Contractor

FIRST REPORTS

SECTION PLAT

..... Ft. from N. Line
1320 Ft. from S. Line
..... Ft. from E. Line
1320 Ft. from W. Line

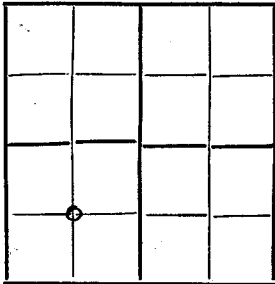

Location..... ✓
Rig up.....
Drilling and Remarks:

RECORD

Cased..... in., ft.
Sand.....
Gas.....
Oil.....
Total Depth.....

PRODUCTION

1st 24 hrs. Nat.....
1st 24 hrs. after shot.....
Gas..... Cu. Ft.
Dry Hole.....
Abandoned.....

Date
JUL 27 1932 CHAS. L. SHERWOOD
192..... Scout

Ellsworth


53 KANSAS Sec. 5 Twp. 14 R. 9 W

Well No. 1 Sarraw
Viking Oil Co. Company
Contractor

CORRECTION

SECTION PLAT

660 Ft. from N. Line
..... Ft. from S. Line
..... Ft. from E. Line
660 Ft. from W. Line

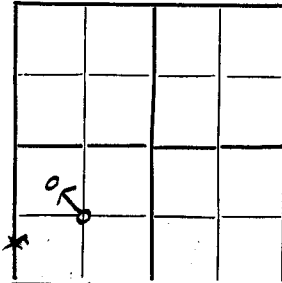

Location.....
Rig up.....
Drilling and Remarks:

RECORD

Cased..... in., ft.
Sand.....
Gas.....
Oil.....
Total Depth.....

PRODUCTION

1st 24 hrs. Nat.....
1st 24 hrs. after shot.....
Gas..... Cu. Ft.
Dry Hole.....
Abandoned.....

Chg Location

Date
AUG 31 1932 CHAS. L. SHERWOOD
192..... Scout

Ellsworth

53 KANSAS
Map No. Sec. 5 Twp. 14 R. 9 W

Map No. KANSAS Sec. 5 Twp. 14 R. 9 W


Well No. 1 *Patran*
Viking Oil Co. Company
Contractor

Well No. 1 - *Patran* Farm
Viking Oil Co. Company

COMPASS

SECTION PLAT

660 Ft. from N. Line
Ft. from S. Line
Ft. from E. Line
660 Ft. from W. Line

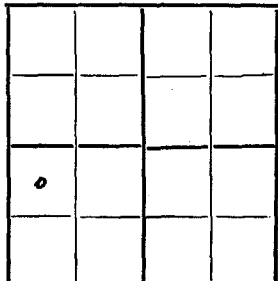


660 Ft. from N. Line

~~1320~~ Ft. from S. Line

Ft. from E. Line

660
~~1320~~ Ft. from W. Line

1932

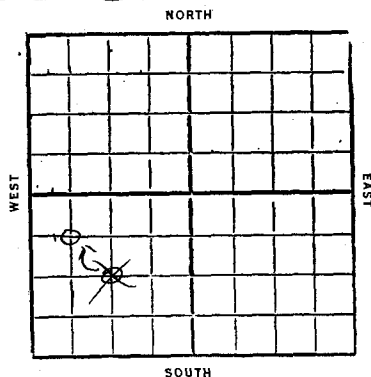

Location
Rig up
Drilling and Remarks:

RECORD
Cased in. ft.
Sand
Gas 1380-1385
Oil
Total Depth 1385

PRODUCTION
1st 24 hrs. Nat.
1st 24 hrs. after shot
Gas 3/4 Cu. Ft.
Dry Hole
Abandoned

Date
OCT 5 1932 CHAS. L. SHERRY Scout

REPORT

Date	REPORT
7/27	Loc
8/3	
8/10	Some material in
8/17	Rig up much
8/24	SD 200'
8/31	UTR 8"-600'
9/7	drldg 1200'
9/14	Gas sand 1385-90 TD 1400 Est 100,000 gas
9/21	SD 1400'
9/30	
10/5	Gas 1380-85 TD 1385 3/4 #4 gas Comp.

Ellsworth

Form 51-5M-11-31-Palace

Map No. KANSAS Sec.

5 Twp. 14 R. 9^w


Well No.

5 Natram
Liking Oil

Farm

Company

NORTH

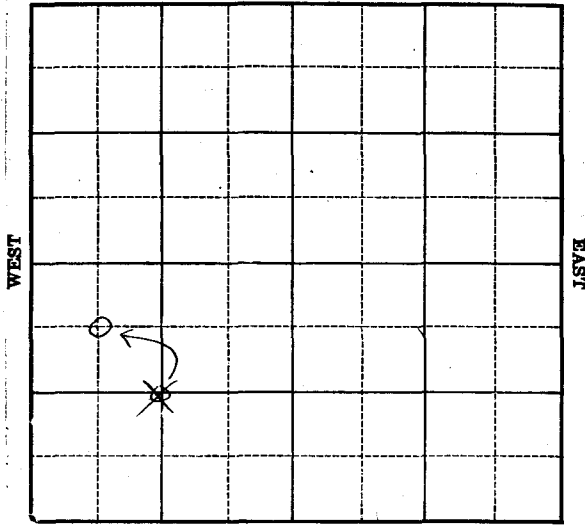

SOUTH

Location
Drilling Remarks

Rig Up
Drilling Remarks

.....

.....

RECORD

PRODUCTION

Cased in. ft.
 Sand
 Gas
 Oil
 Total Depth

1st 24 hrs. Nat.
 1st 24 hrs. after shot
 Gas cu. ft.
 Dry Hole
 Abandoned