

Edwards with
Map No. 53 Sec. 6 Twp. 14 R. 9WWell No. 1-HesperP. H. Joseph Company
Contractor

FIRST REPORTS

Ft. from N. Line

660 Ft. from S. Line990 Ft. from E. Line

Ft. from W. Line

SECTION PLAT

			0

Location

Rig up

Drilling and Remarks:

Est 171900P.D. 1393

RECORD

Cased in. ft.

Sand 1383-93

Gas

Oil

Total Depth

PRODUCTION

1st 24 hrs. Nat.

1st 24 hrs. after shot

Gas Cu. Ft.

Dry Hole

Abandoned

Date

5-23-37 19

ORVAL MANNSCHRECK

Scout

Edwards with
Map No. 53 Sec. 6 Twp. 14 R. 9WWell No. 1-HesperP. H. Joseph Company
Contractor

COMPLETED

SECTION PLAT

Ft. from N. Line

660 Ft. from S. Line990 Ft. from E. Line

Ft. from W. Line

			0

Location

Rig up

Drilling and Remarks:

Est 5 mid
900

RECORD

Cased in. ft.

Sand 1383-93

Gas

Oil

Total Depth 1393

PRODUCTION

1st 24 hrs. Nat.

1st 24 hrs. after shot

Gas Cu. Ft.

Dry Hole

Abandoned

Date

6-13-37 19

ORVAL MANNSCHRECK

Scout

Ellsworth


Map No. **KANSAS** Sec. 6 Twp. 14 R. 9W
Well No. 1 Kasper Farm
P. H. Joseph Company

_Ft. from N. Line

660 Ft. from S. Line

990 Ft. from E. Line

Ft. from W. Line

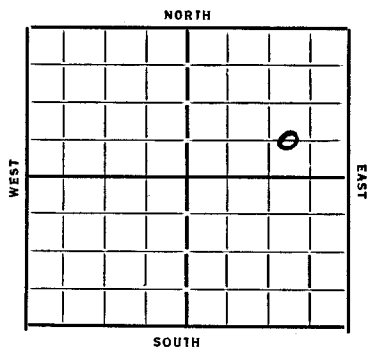

REPORT

COMPLETED

Date	REPORT
5/23	Sand 1383-93 Est 17m Gas SD
5/31	— 6/7 —
6/13	Sand 1383-93 TD 1593 Est 5 m Gas

Location _____
Drilling Remarks _____

Rig Up_____

Drilling Remarks

RECORD

Cased _____ in. _____ ft.
 Sand _____
 Gas _____
 Oil _____
 Total Depth _____

PRODUCTION


1st 24 hrs. Nat. _____
1st 24 hrs. after shot _____
Gas _____ cu. ft. _____
Dry Hole _____
Abandoned _____

Form 51-5M-11-81-Palace

Ellsworth

Map No. **KANSAS** Sec. **6** Twp. **14** R. **1**
Well No. **P 1/2 Kasper** Farm
P 2/2 Joseph Company

NORTH

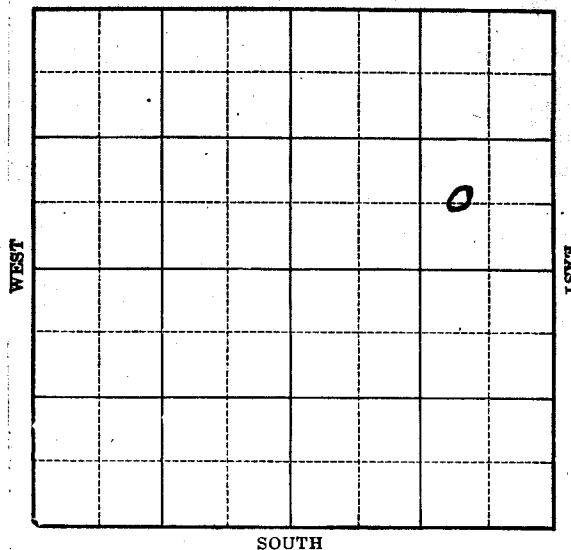

SOUTH