

Form 26-1M Bk. 9-27

Map No. **KANSAS** Sec. **6** Twp. **14** R. **9W**

Well No. **1 Kasper**

**Seitz & Milton** Company  
Contractor

SECTION PLAT

|  |  |  |  |
|--|--|--|--|
|  |  |  |  |
|  |  |  |  |
|  |  |  |  |
|  |  |  |  |

..... Ft. from N. Line

**330** Ft. from S. Line

..... Ft. from E. Line

**330** Ft. from W. Line

FIRST REPORTS

| Location.....<br>Rig up.....<br>Drilling and Remarks:<br><b>ROG</b> | RECORD                      |           |
|---------------------------------------------------------------------|-----------------------------|-----------|
|                                                                     | Cased..... in.,             | ..... ft. |
|                                                                     | Sand.....                   |           |
|                                                                     | Gas.....                    |           |
|                                                                     | Oil.....                    |           |
|                                                                     | Total Depth.....            |           |
|                                                                     | PRODUCTION                  |           |
|                                                                     | 1st 24 hrs. Nat.....        |           |
|                                                                     | 1st 24 hrs. after shot..... |           |
|                                                                     | Gas.....                    | Cu. Ft.   |
|                                                                     | Dry Hole.....               |           |
|                                                                     | Abandoned.....              |           |

Date **SEP 10 1930**  
**S. J. LEWIS** Scout

Form 26-1M Bk. 9-27

Map No. **KANSAS** Sec. **6** Twp. **14** R. **9W**

Well No. **1 Kasper**

**Seitz & Milton** Company  
Contractor

SECTION PLAT

|  |  |  |  |
|--|--|--|--|
|  |  |  |  |
|  |  |  |  |
|  |  |  |  |
|  |  |  |  |

..... Ft. from N. Line

**330** Ft. from S. Line

**330** Ft. from E. Line

..... Ft. from W. Line

CORRECTION

| Location.....<br>Rig up.....<br>Drilling and Remarks:<br><b>Repeated<br/>S.W.E</b> | RECORD                      |           |
|------------------------------------------------------------------------------------|-----------------------------|-----------|
|                                                                                    | Cased..... in.,             | ..... ft. |
|                                                                                    | Sand.....                   |           |
|                                                                                    | Gas.....                    |           |
|                                                                                    | Oil.....                    |           |
|                                                                                    | Total Depth.....            |           |
|                                                                                    | PRODUCTION                  |           |
|                                                                                    | 1st 24 hrs. Nat.....        |           |
|                                                                                    | 1st 24 hrs. after shot..... |           |
|                                                                                    | Gas.....                    | Cu. Ft.   |
|                                                                                    | Dry Hole.....               |           |
|                                                                                    | Abandoned.....              |           |

Date **SEP 17 1930**  
**S. J. LEWIS** Scout

*Berworth*  
Form 202A-5M-11-29-33005

Map No. KANSAS Sec. 6 Twp. 14 R. 9<sup>th</sup>

Well No. 1- Kasper Farm  
Seitz & Melton Company


       Ft. from N. Line

330 Ft. from S. Line

330 Ft. from E. Line

330 Ft. from W. Line

19.30

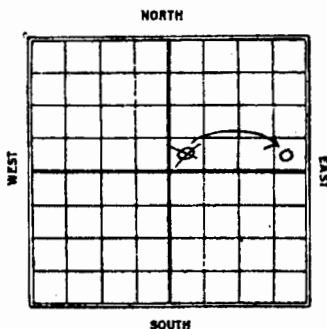

Date REPORT

|       |                    |
|-------|--------------------|
| 9/10  | Reel               |
| 9/17  | Run up             |
| 9/24  |                    |
| 10/1  | Spud               |
| 10/8  | SD                 |
| 10/15 | SD 330'            |
| 10/22 |                    |
| 10/29 |                    |
| 4/5   |                    |
| 4/12  |                    |
| 4/19  |                    |
| 4/25  |                    |
| 12/3  |                    |
| 12/10 |                    |
| 12/17 |                    |
| 12/23 |                    |
| 12/30 |                    |
| 1/3   |                    |
| 1/7   | Qty out 330        |
| 1/14  | TD 333' fsg bauler |
| 1/21  | Drilg 573          |
| 1/28  | " 880'             |

2/4- 1st gas at 1382  
drilg 1476

2/11- SD 1476

2/18 —

2/25 —

3/4- TD 1614 fsg tools

3/11- SD 1740'

3/18- TD 1740' fsg tools

3/25 —

4/1 —

4/8 —

4/15- 10"-1734  
drilg 2018'

4/22 Est 1st 2nd gas at 2075  
drilg 2095'

4/29 Had 1 3/4" gas 2075-80  
8"-2109  
drilg 2170'

5/6- UIR 8"-2420'

5/13- UIR 8"-2655'

5/20- show gas 2550-55  
8"-2648'

5/27- Drilg 2755'  
6"-2962  
drilg 2976'

6/3- Top Oswald 2819  
HFV 2985  
UIR 6"-3018'

6/10- Information refused  
drilg about 3100'

6/17- 6" csg trouble about 3150

6/24- Qty out at 3160'

7/1- drilg 3176'


7/8- 7 7/8" 3235'- S.D 3260'

53 Ellsworth  
 Map No. KANSAS Sec. 6 Twp. 14 R. 9 W  
 Well No. 1 Kasper  
Seitz & Melton Company

Contractor

## COMPLETED

## SECTION PLAT

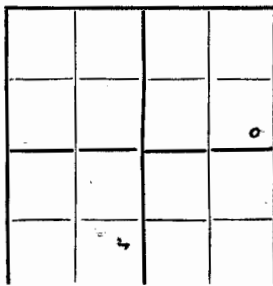

..... Ft. from N. Line  
330 Ft. from S. Line  
330 Ft. from E. Line  
 ..... Ft. from W. Line

## ABANDONED

Location.....

Rig up.....

Drilling and Remarks:

HF W 3690-3705

D+a, 3710

## RECORD

Cased..... in., ..... ft.  
 Sand.....  
 Gas.....  
 Oil.....  
 Total Depth 3710

## PRODUCTION

1st 24 hrs. Nat.....  
 1st 24 hrs. after shot.....  
 Gas..... Cu. Ft.  
 Dry Hole ☒  
 Abandoned ☒


Date

SEP 30 1931

192 CHAS. L. SHERWOOD Scout

Map No. Kans Sec. 6 Twp. 14 R. 9 W  
 Well No. 1 Kasper Farm  
Seitz & Melton Company

NORTH

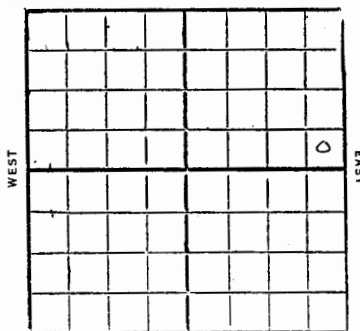

..... Ft. from N. Line

330 Ft. from S. Line330 Ft. from E. Line

..... Ft. from W. Line

SOUTH

1931

Date

## REPORT

7/15 Cgt 3214-50'  
 T.D. 3256 UIR 6"  
 7/22 T.D. 3290' Sem Cave  
 7/29 6"-3300  
 T.D. 3350' fsg tools  
 8/5  
 8/12 UIR 6" below 3300'  
 Refuse to give out information on this well  
 8/19  
 8/26 Drlg 3400'  
 9/2 SD 3576 for 5"  
 9/9  
 9/16 TD 3576  
 Prep to run 5" csq  
 9/23 5"-3560  
 Drlg 3605'  
 9/30 HFOW 3690-3705  
 T.D. 3710  
 Dry & Abandon

City & Suburban Company

|   |   |
|---|---|
| Location _____   | Rig Up _____   |
| Drilling Remarks<br>_____<br>_____<br>_____<br>_____<br>_____<br>_____<br>_____<br>_____<br>_____<br>_____<br>_____ | Drilling Remarks<br>_____<br>_____<br>_____<br>_____<br>_____<br>_____<br>_____<br>_____<br>_____<br>_____<br>_____ |
| <b>RECORD</b>   | <b>PRODUCTION</b>                                                                                                   |
| Cased _____ in. _____ ft.                                                                                           | 1st 24 hrs. Nat. _____                                                                                              |
| Sand _____   | 1st 24 hrs. after shot _____                                                                                        |
| Gas _____   | Gas _____ cu. ft.                                                                                                   |
| Oil _____   | Dry Hole _____   |
| Total Depth _____                                                                                                   | Abandoned _____   |