

Ellis

KANSAS ✓

Sec. 9 Twp. 14 R. 16^W

Well No. #1 Munk Farm

Anschutz Drlg. Company

Hertel Pool Contractor


Ft. from N. Line

330 Ft. from S. Line

Ft. from E. Line

330 Ft. from W. Line

SE $\frac{1}{4}$ SW SW SE

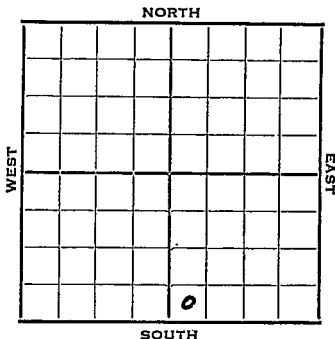

1952 Elev. 1901' REPORT

10/22 Spud 10-17-52
8" @ 211
Anhy 985'
Drlg. 1730'

10/29 Heeb 3102' Tor. 3122' Lans. 3150'
DST 3123-31, 1/2 hr, 10' M 910#
DST 3152-70, 1/2 hr, 12' M
DST 3177-3201, 1 hr, 70' wtr. 880#
Drlg. 3252'

11/5 Spud 10-17-52
D&A TD 3450' 8" @ 211
Anhy 985 Heeb. 3102
Tor. 3122 Lans. 3150
DST 3123-31 open $\frac{1}{2}$ hr. rec. 10' mud
910#
DST 3123-31 open $\frac{1}{2}$ hr. rec. 10' mud
910#
DST 3152-70 open $\frac{1}{2}$ hr. rec. 12' mud
40#
DST 3177-3201 open 1 hr. rec. 70' wtr.
880# B KC 3345 Cong. 3397
Arb. 3403
DST 3405-12 open $\frac{1}{2}$ hr. rec. 5' mud
35#
DST 3410-30 open $\frac{1}{2}$ hr. rec. 15' mud
70# TD 3450' D&A

ABANDONED


County Ellis State Kansas

Sec. 9 (Blk. Twp.) 14 (Sur. Rge.) 16W Map No.

Operator Anschutz Drlg.

Well No. 1 Farm Munk

Elev. _____ Location SW SE SE

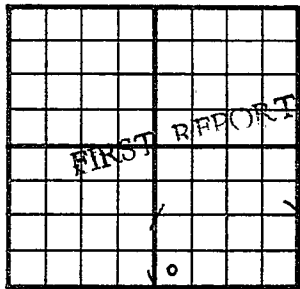

330 Ft. From S Line SE

330 Ft. From W Line Quarter

Ist. Report OCT 22 1952

Completion _____

Remarks _____

Spudding Date 10-17-52

Drilg. Data Hertel Pool

8" @ 211 Anhy 985 drilg. 1730

Scout Cards AD
Land Small Map
Land Wall Map B
Tracings
France Map
Pierce Map
Misc.

OCT 27 1952

Scout Cards
Land Small Map
Land Wall Map
Tracings
France Map
Pierce Map
Misc

NOV 12 1952

Prig. Date