


DX 78-1 Ellis

Section 9 Township 14 Range 16W

Well No. #1 Munk

Company Franco-Central Oil

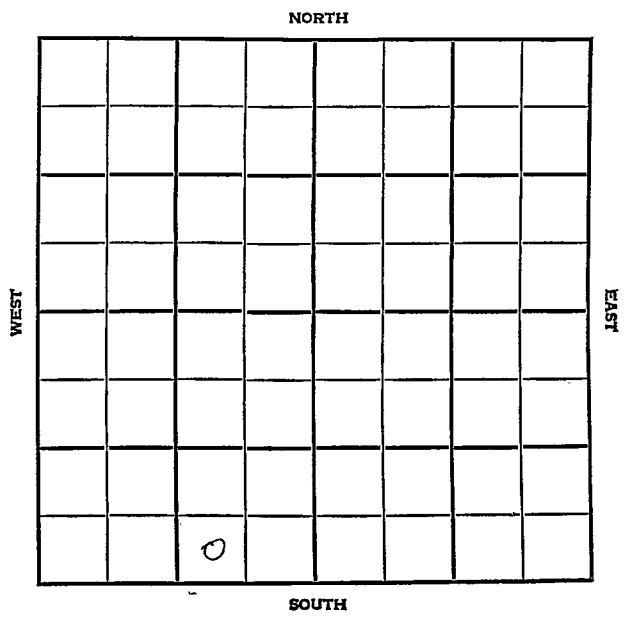

Ellis

KANSAS

SEC.	TWP.	R.
9	14	16W


WELL NO. #1 Munk FARM

COMPANY Franco-Central Oil

CONTRACTOR Lewis

WILDCAT

_____ FT. FROM N. LINE
 _____ FT. FROM S. LINE
 _____ FT. FROM E. LINE
 _____ FT. FROM W. LINE

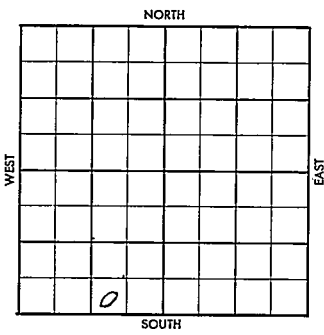

SW SE SW

1956	ELEVATION 1883'	REPORT
------	--------------------	--------

7-11 Comm. 7-2-56
 8" @ 220 w/125
 Drlg. 3143
 KC 3126'

7-18 DST 3033-55 op 1 hr, rec. 64' MSW,
 950/15".
 DST 3128-43 op 30 min. rec. 5' mud,
 BHP 50/15"
 DST 3390-3402 op 1 hr, rec. 185' MSW /
 Sc. oil, 1000/15"
 D & A
 Tp. 2836'; H. 3078'; Tr. 3097';
 BKC 3360'; Cherty 3370'; A. 3389';
 TD 3402'

ABANDONED

County Illis Elev. 1883
 Sec. 9 Twp. 1h Rge. 16W
 Company Tranco-Central Oil
 Farm Name Kunk No. 1

TOPS	DEPTH	LOG	DATUM	Loc. in Sec.
Anb.				3rd SW 27
Tp.	2826			
H.	3078			
Tr.	3097			
Dg.				
Bl.				
L.				Geol.
K.C.	3126			
B.K.C.	3360			Contr.
Ce.				
C. <u>cherty</u>	3370			<u>Lewis</u>
M.				Pool
M.				
K.				
Mz.				
Mo.				
V.				
S.				
S.				
A	3389			
R.				
PE				
G.				
TD	3402			

ABANDONED
 JUL 18 1956

Date Comm. 7-2-56
8" 020/125 drl. 3113 JUL 18 56

DST 3033-55 1hr 64' MSW
950/15" DST 3128-43 30"
rec 5' Md BHP 50/15" DST
3390-3402 1hr 185' MSW +
sc. oil 1000/15"

DEA