


Section 9 Township 14 Range 16 WWell No. # 1 SchulteCompany Graybol Contracting Corp

ELLIS

KANSAS

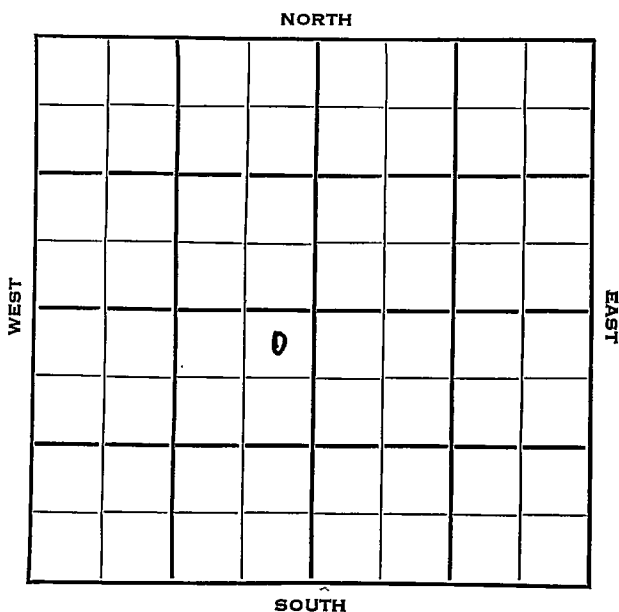

SEC.	TWP.	R.
9	14	16W

WELL NO.

1 Schulte

FARM

COMPANY

Graybol Contracting Corp.

CONTRACTOR

Graybol

Hertel Pool


330 Ft. from N. Line

Ft. from S. Line

330 Ft. from E. Line

Ft. from W. Line

NE NE SW

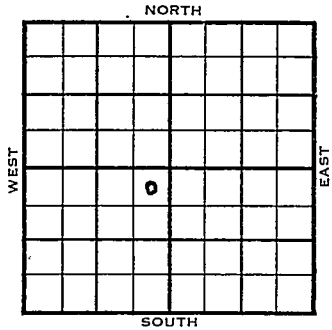

	ELEVATION	REPORT
1953	1897'	

9/9 Spud 8-31-53
8" @ 215
Anhy 980'
Drlg. 2984'

9/16 Spud 8-31-53 D & A TD 3435
8" @ 215 Anhy 980 Top 2824
Heeb 3102 Tor. 3120 Lans 3149
DST 3150-70 open $\frac{1}{2}$ hr rec 5' mud
B KC 3346' Marm 3357' Arb. 3400
TD 3435 D & A

ABANDONED

County Ellis State Kansas

Sec. 9 (Blk. Twp.) 14 (Sur. Rge.) 16W Map No.

Operator Graybol Contracting Corp.

Well No. **1** Farm **Schulte**

Elev.	Location	NE	NE	SW
-------	----------	----	----	----

[illegible]

330 Ft. From N. Line SW

330 Ft. From E Line Quarter

1st. Report SEP 9 1953

Completion

Remarks Lion Oil farmout
Graybol - Contr.


Spudding Date 8-31-53

Drlg. Data Hertel Pool

8" @ 215 Anhy 980 drlg. 2984

J. G. McGEHEE

County Ellis State Kansas
 Sec. 9 (Blk.) 14 (Sur.) 16W Map No.
 Operator Graybol Contracting Corp.
 Well No. 1 Farm Schulte
 Elev. 1897 Location NE NE SW

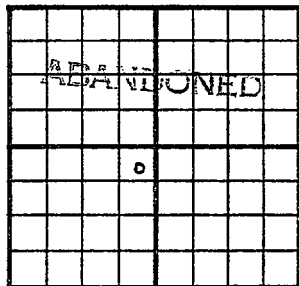

330 Ft. From N Line SW
330 Ft. From E Line Quarter
 Ist. Report
 Completion SEP 16 1952
 Remarks Hertel Pool
Graybol - Contr.
 Spudding Date 8-31-53

Drlg. Data D & A TD 3435
8" @ 215 Amhy 980 Top. 2824
Heeb. 3102 Tor. 3120 Lans. 3149
DST 3150-70 open $\frac{1}{2}$ hr. Rec. 5' mud
B KC 3345 Marm. 3357 Arb. 3400 TD 3435
D & A

J. G. McGEHEE