


Section 9 Township 14 Range 15-W

Well No. 1 - Furthmeger (Furthmeyer)

Company Central Pet.

NORTH

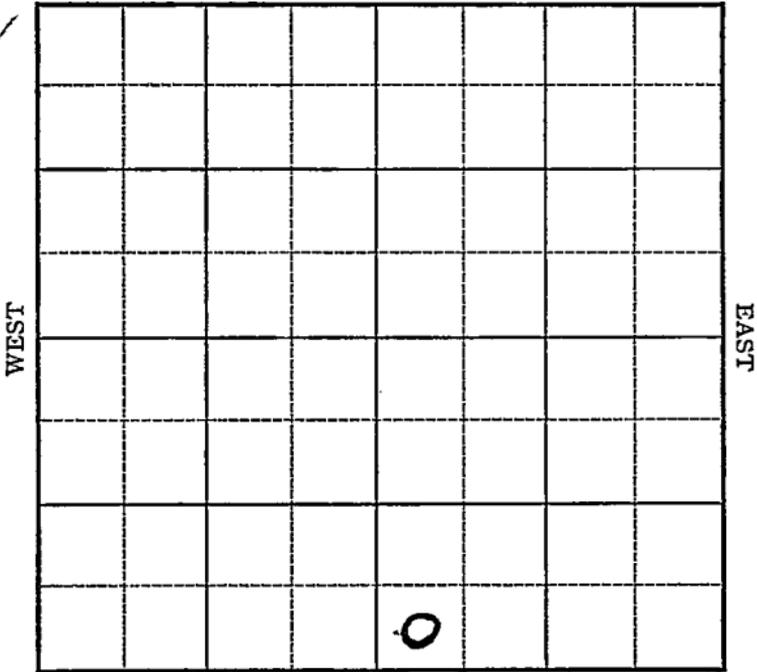

SOUTH



Sec. 9 Twp. 14 R. 15-W


Well No. #1 Furthmeyer Farm
Central Pet. Company

 Ft. from N. Line

330 Ft. from S. Line

 Ft. from E. Line

330 Ft. from W. Line

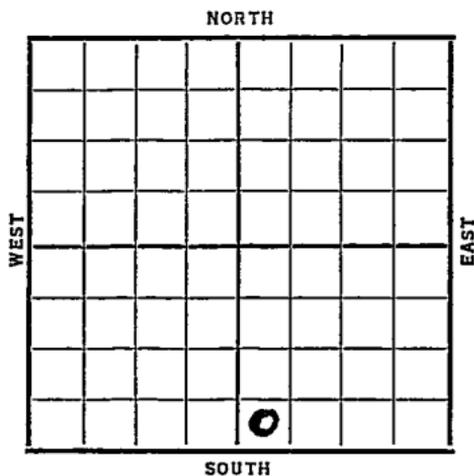

Date	REPORT
1937	
8/4	Dlg. 2000'
8/13	15" @ 50'. 12" @ 395'.
	10" @ 620'. Anhy 898'.
	8" @ 930'. S.O. 2470-80'.
	6" @ 2639'. T.D. 2640'.
	U. R. 6".
8/20	T.D. 2750' SD.
8/28	K.C. 3022' 1 5" @ 3044'.
	T.D. 3050'. WOC.
9/1	5" @ 3044'.
	K.C. 3022'.
	T.D. 3167'.
	Sm. S.O.
	1000 acid.
	No help.
	ABANDONED

Russell KANSASMap No. _____ Sec. 9 Twp. 14 R. 15^WWell No. 1 - FurthmeyerCentral Pet, Company

Contractor _____

FIRST REPORT

SECTION PLAT

_____ Ft. from N. Line

330 Ft. from S. Line

_____ Ft. from E. Line

330 Ft. from W. Line

		0	

Location _____

Rig up _____

Drilling and Remarks:

Dlg - 2000

RECORD

Cased _____ in., _____ ft.

Sand _____

Gas _____

Oil _____

Total Depth _____

PRODUCTION

1st 24 hrs. Nat. _____

1st 24 hrs. after shot _____

Gas _____ Cu. Ft.

Dry Hole _____

Abandoned _____

Date

AUG 1 - 1937

19

H. D. Hatfield Scout

KANSAS

Russell

Map No. _____ Sec. 9 Twp. 14 R. 15^w

Well No. 1 - Furthmeyer
Central Pet Company

Contractor _____

ABANDONED

SECTION PLAT

		0	

_____ Ft. from N. Line

330 Ft. from S. Line

_____ Ft. from E. Line

330 Ft. from W. Line

Location _____

Rig up _____

Drilling and Remarks:

Sm. S.O.

1000 Acid

No help

DVA

RECORD

Cased 5 in., 3044 ft.

Sand K.C., 3022

Gas _____

Oil _____

Total Depth 3167

PRODUCTION

1st 24 hrs. Nat. _____

1st 24 hrs. after shot _____

Gas _____ Cu. Ft.

Dry Hole _____

Abandoned _____

Date

SEP 1 1937 19

H. D. Hatfield Scout