

Russell


KANSAS

SECTION 9 TOWNSHIP 14 RANGE 15 W

WELL NO. #1 Furthmeyer

COMPANY Orville Furthmeyer

NORTH

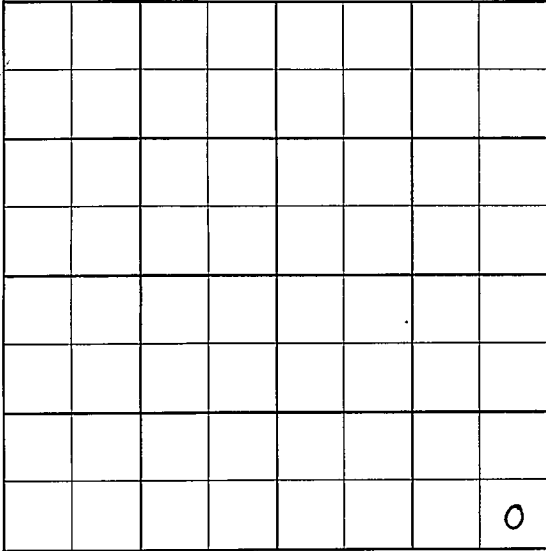

							0

WEST

EAST

SOUTH

✓

MINAS

SEC.	TWP.	R..
9	14	15W

WELL NO.

#1 Furthmeyer

FARM

COMPANY

Orville Furthmeyer

CONTRACTOR

Sidey

Gorham

Ft. from N. Line

Ft. from S. Line


Ft. from E. Line

Ft. from W. Line

SE SE SE

Sohio - FO

NORTH

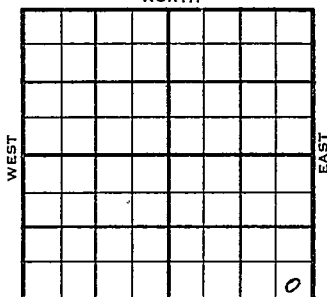

SOUTH

1955	ELEVATION	REPORT
	1846	

10/26 Comm 10-22-55
8th @ 889/400
Anh 876
WOC

11/9

Comm 10-22-55
8th @ 889/400

Anh	876
Tp	2718
H	2944
Tr	2964
Dg	2987
KC	3001
BKC	3228
G Wash	3234
Gr	3240
TD	3248

DST 2976-3010 open 1 hr rec 180'
gas 90' so & gcm 0/20" DST 3017-
44 open 1 hr rec 120' gas 90'
socmw 530/20"

D & A

ABANDONED

County Russell Elev. _____
Sec. 9 Twp. N11 Rge. 15W
Company Orville Furthmeyer
Farm Name Furthmeyer No. 1

TOPS	DEPTH	LOG	DATUM
Anh.	876		
TP.			
H.			
Tr.			
Dg.			
Bl.			
L.			
K.C.			
B.K.C.			
Ce.			
C.			
M.			
M.			
K.			
Mz.			
Mo.			
V.			
S.			
S.			
A.			
R.			
Pe.			
G.			
T.D.			

Loc. in Sec. SE SE SE
Geol. _____
Contr. _____
Sidey
Pool _____
Gorham

FIRST REPORT

DEC 26 '55

Date Comm. 10-22-55 Sohio FO
8th @ 889/400 WOC

13

County Russell Elev. 1846
 Sec. 9 Twp. 14 Rge. 15W
 Company Grville Furthmeyer
 Farm Name Furthmeyer No. 1

TOPS	DEPTH	LOG	DATUM	Loc. in Sec.
Anh.	876			SE SE SE
Tp.	2718		872	
H.	2944		1098	
Tr.	2964		1118	
Dg.	2987		1141	
BL.				
L.				
K.C.	3001		1155	Geol.
B.K.C.	3228		1382	Contr.
Ce.				Sidey
C.				
M.				Pool
M.				Gorham
K.				
Mz.				
Mo.				
V.				
S.				
S.				
A.				
R.				
Pe.				
G. Wash	3234		1388	
Dr.	3240		1394	
T.D.	3248			

ABANDONED

Date Comm. 10-22-55 NOV 9 1955
 8" @ 889/400 DST 2976-3010 open 1 hr.
 rec. 180' gas 90' so & gcm 0/20"
 DST 3017-44 open 1 hr. rec. 120' gas
 90' socmw 530/20"

D & A