


Map No. KANSAS Sec. 9 Twp. 14 R. 15^w
Well No. 6 - Lorkham Farm
Mid-west Company

330 Ft. from N. Line
____ Ft. from S. Line
____ Ft. from E. Line
330 Ft. from W. Line

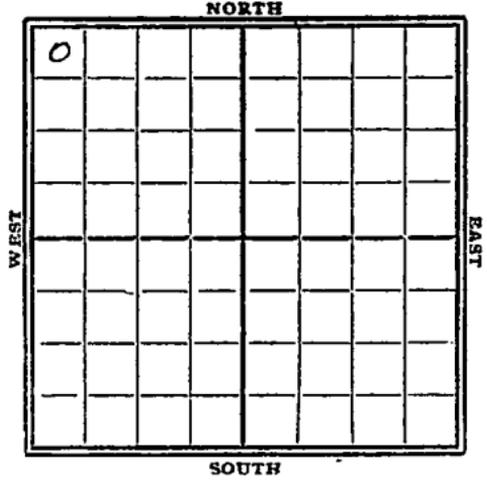

1929

Date	REPORT
11/20	Location
11/27	Bldg Rig
12/14	Rig
12/11	Ran up
12/18	Spud 2140'
12/23	dry 680'
12/30	" 1520'
1930	
1/8	" 2230'
1/15	" 2515'
1/22	Show oil, 2650'
	dry 2680'
1/29	" 2900'
2/5	3090 3066-71 Swabbed.
2/12	Sand 3066-71' T.D. 3105'
	Swab 40 bbl oil Sump.

Resett 74
 Map No. **ANSAS** Sec. 9 Twp. 24 R. 15W
 Well No. 6 Graham

Alid West Company
 Contractor

SECTION PLAT

330 Ft. from N. Line
 _____ Ft. from S. Line
 _____ Ft. from E. Line
330 Ft. from W. Line

0			

FIRST REPORTS

Location ✓
 Rig up _____
 Drilling and Remarks:

RECORD

Cased _____ in., _____ ft.
 Sand _____
 Gas _____
 Oil _____
 Total Depth _____

PRODUCTION

1st 24 hrs. Nat. _____
 1st 24 hrs. after shot _____
 Gas _____ Cu. Ft.
 Dry Hole _____
 Abandoned _____

Date

NOV 20 1929

S. J. LEWIS Scout

Russell

Map No. **KANSAS** Sec. 9 Twp. 14 R. 15N

Well No. 6 Gorham

Mid West Company

Contractor

SECTION PLAT

220 Ft. from N. Line

..... Ft. from S. Line

..... Ft. from E. Line

320 Ft. from W. Line

0			

COMPLETED

Location.....

Rig up.....

Drilling and Remarks:

Swab 40 8 1/2

RECORD

Cased..... in., ft.

Sand 3066-71

Gas.....

Oil.....

Total Depth 3105

PRODUCTION

1st 24 hrs. Nat.....

1st 24 hrs. after shot.....

Gas..... Cu. Ft.

Dry Hole.....

Abandoned.....

Date

FEB 12 1930

S. J. LEWIS Scout