


Section 9 Township 14 Range 15W

Well No. #1 Mermis

Company Coralena

NORTH

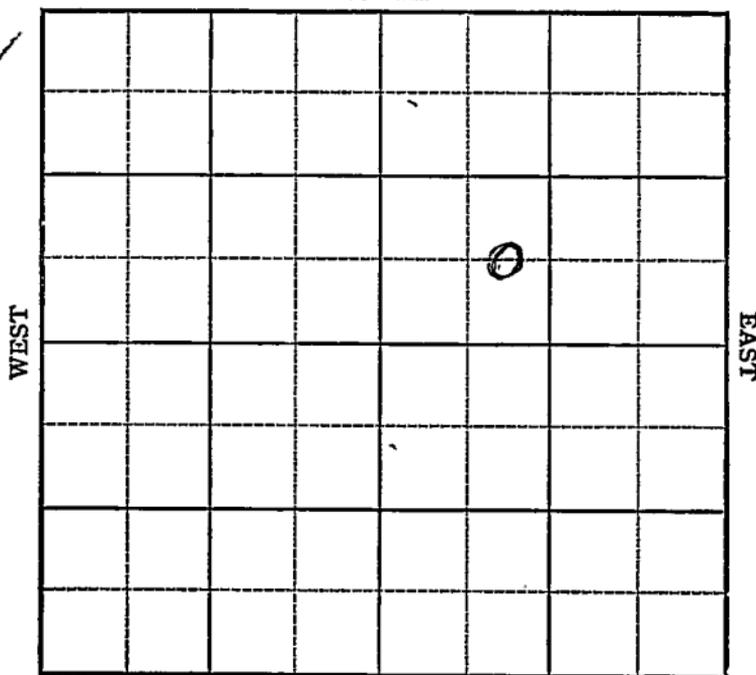

SOUTH

KANSAS

Sec. 9 Twp. 14 R. 15W

Well No. #1 Mermis Farm

Coralena Company


Gorham

_____ Ft. from N. Line

660 Ft. from S. Line

_____ Ft. from E. Line

990 Ft. from W. Line

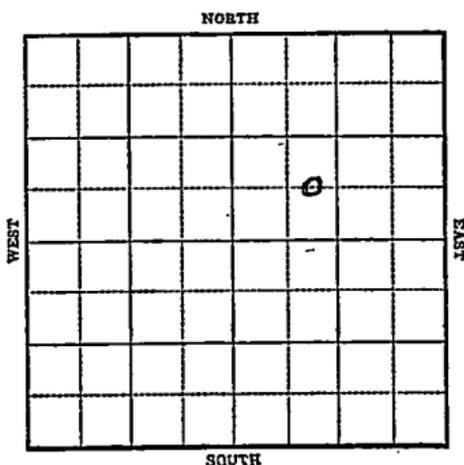

1944

R E P O R T

2/23

Location

3/1

"

3/8

"

3/16

Surface Hole 448'

3/22

10" @ 546
Drlg. 2745

3/29

Topeka 2745
Dodge 2989.
Lans 3016
5" @ 3035
TD 3449
3000 acid

4/5

TD 3077 corrected
1000 acid
water squeeze.

4/12

" "

4/19

" " "

4/26

PB 45 shots 2875-97
VSSO

5/3

Sq. perf.

5/10

"

OVER

1944

5/17

Topeka 2745

Lansing 3016

5" - 3035

Plug Back 2900

40 shots 2864-87

41 shots 2740-60

1000 acid

Total Depth 3077

ABANDONED

KANSAS

Pool Name Gorham

Map No. 72 Sec. 9 Twp. 14 R. 15W

Well No. 1 Mermis

Coralena Company

ABANDONED Contractor

C E L S W T E

SECTION PLAT

		o	

_____ Ft. from N. Line

660 Ft. from S. Line

_____ Ft. from E. Line

990 Ft. from W. Line

Russell County

RECORD

Location _____

Cased _____ in., _____ ft.

Rig up _____

Sand _____

Drilling and Remarks:

Gas _____

*Wofka 2745
Lane 3014
5' @ 3035.
P.B. 2900
40 shot to 2864-87
41 " 2742-60
1000 acid*

Oil _____

Total Depth 3077

PRODUCTION

1st 24 hrs. Nat. _____

1st 24 hrs. after shot _____

Gas _____ Cu. Ft.

Dry Hole _____

Abandoned _____

Date

MAY 17 1944 19

S. J. LEWIS Scout

KANSAS

Map No. 72 Sec. 9 Twp. 14 R. 15WWell No. #1 MermisCoralena

Company

FIRST REPORT

Contractor

C E L S W N E

SECTION PLAT

Ft. from N. Line

660

Ft. from S. Line

Ft. from E. Line

990

Ft. from W. Line

Gorham PoolLocation X

Rig up _____

Drilling and Remarks:

RECORD

Cased _____ in., _____ ft.

Sand _____

Gas _____

Oil _____

Total Depth _____

PRODUCTION

1st 24 hrs. Nat. _____

1st 24 hrs. after shot _____

Gas _____ Cu. Ft.

Dry Hole _____

Abandoned _____

Date

FEB 23 194419S. J. LEWIS

Scout