

KANSAS


Russell

FORM 51 5M 1-42 PETROL

Section 9 Township 14 Range 15-W

Well No. #1 Aley

Company Coralena

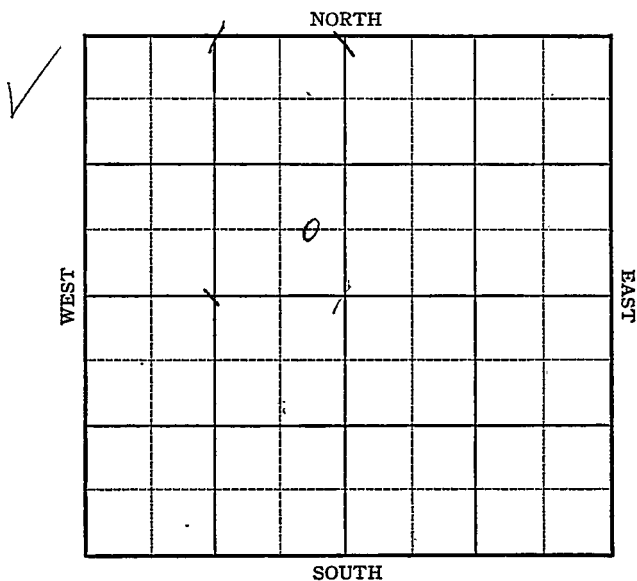

KANSAS

Russell

Sec. 9 Twp. 14 R. 15-W

Well No. #1 Aley Farm

Coralena Company

Gorham


 Ft. from N. Line

660 Ft. from S. Line

330 Ft. from E. Line

 Ft. from W. Line

Elev. 1869

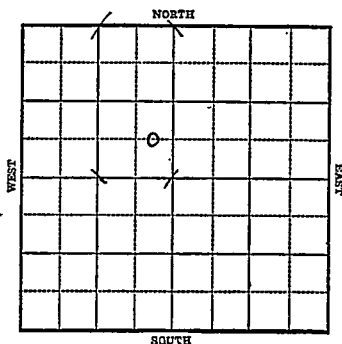

1943

R E P O R T

7/21 Rotary

7/28 10" @ 94'
Anky 944
Drlg. 1860'

8/4 Topeka 2750
Lans 3021
Drlg. 3035'

8/11 T.D. 3102
5" @ 3065'
Rust

8/18 "

8/25 Lans 3021
5" @ 3065
2000 acid
Pump 211 Pot.
T.D. 3102'
Gravity 35.6

COMPLETED

Map No. 72 Sec. 9 Twp. 14 R. 15W

Well No. 1 Aley

Coralena

Company

FIRST REPORT

Contractor

C E L S E N W


Ft. from N. Line

660 Ft. from S. Line

330 Ft. from E. Line

Ft. from W. Line

SECTION PLAT

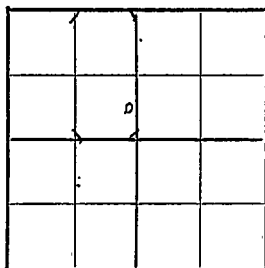

GORHAM POOL

Location

Rig up

Drilling and Remarks:

Rotary

RECORD

Cased _____ in., _____ ft.

Sand _____

Gas _____

Oil _____

Total Depth _____

PRODUCTION

1st 24 hrs. Nat. _____

1st 24 hrs. after shot _____

Gas _____ Cu. Ft.

Dry Hole _____

Abandoned _____

Date

JUL 21 1943 19

S. J. LEWIS Scout

KANSAS

Map No. 72 Sec. 9 Twp. 14 R. 15WWell No. 1 AleyCoralena

Company

COMPLETED

Contractor

C E L S E N W

SECTION PLAT

 Ft. from N. Line660 Ft. from S. Line330 Ft. from E. Line Ft. from W. Line

Gorham Pool

Location

Rig up

Drilling and Remarks:

Lans 3021
5-103065
2000 acid

Pump 211 P & D

356 ft

RECORD

Cased in., ft.Sand Gas Oil Total Depth 3102

PRODUCTION

1st 24 hrs. 1st 24 hrs. after shot Gas Cu. Ft.Dry Hole Abandoned

Date

AUG 25 1943

19

S. J. LEWIS Scout