

KANSAS

Russell


FORM 51 5M 1-42. PETROL

Section 9 Township 14 Range 15-W

Well No. #3 Furthmyer

Company A. H. Witt

NORTH

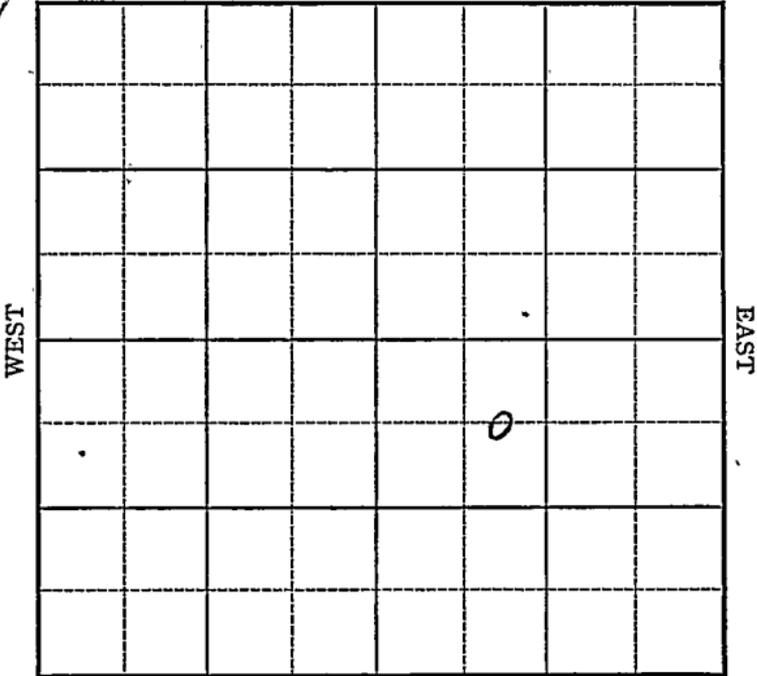

SOUTH



KANSAS Russell

Sec. 9 Twp. 14 R. 15 W

Well No. #3 Furthmyer Farm

A. H. Witt Company

Gorham


660 Ft. from N. Line

_____ Ft. from S. Line

_____ Ft. from E. Line

990 Ft. from W. Line

Elev. 1048

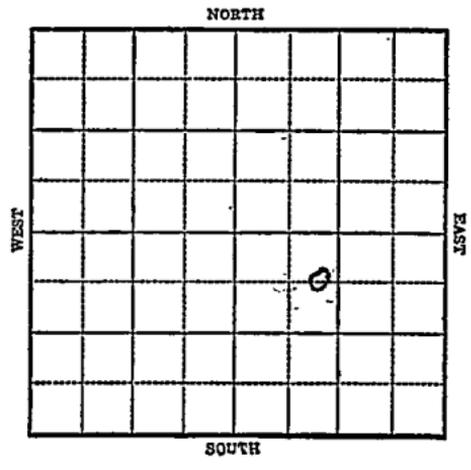

1943

R E P O R T

6/30	Location.
7/7	"
7/15	"
7/21	Derrick
7/28	"
8/4	"
8/11	"
8/18	"
8/25	"
9/1	"
9/8	15" @ 348 12" @ 575 Drlg. 735
9/15	Anhy 885 10" @ 890' Drlg. 1715'
9/22	8" @ 2300 S. Gas 2460 T.D. 2930 UR 8"

OVER

1943
9/29 Topeka 2737
8" @ 2530'
SD 2930
10/6 Lans 2999 SO
EQD. 3000
Run 7"
10/13 3024-3030 Land 3005 in oil
3026 to 3032 T.D.
7" @ 2998-850' oil 16 hrs.
10/20 3000 acid
10/27 Lans 3005
7" @ 2998
3000. acid
Pump 392 Pot.
T.D. 3032
Gravity 37.2

COMPLETED

KANSAS

Map No. 2 Sec. 9 Twp. 14 R. 15WWell No. 3 Furthmyer

A. H. Witt

Company

FIRST REPORT

Contractor

C EL NW SE

SECTION PLAT

660 Ft. from N. Line

_____ Ft. from S. Line

_____ Ft. from E. Line

990 Ft. from W. Line

		o	

GORHAM POOL

Location XXX

Rig up _____

Drilling and Remarks:

RECORD

Cased _____ in _____ ft.

Sand _____

Gas _____

Oil _____

Total Depth _____

PRODUCTION

1st 24 hrs. Nat. _____

1st 24 hrs. after shot _____

Gas _____ Cu. Ft.

Dry Hole _____

Abandoned _____

Date

JUN 30 1943

19

S. J. LEWIS

Scout

Map No. 72 Sec. 9 Twp. 14 R. 15WWell No. 3 FurthmyerA. H. Witt CompanyCOMPLETED Contractor

C E L N W S E

SECTION PLAT

660 Ft. from N. Line

_____ Ft. from S. Line

_____ Ft. from E. Line

990 Ft. from W. Line

		o	

Gorham Pool

Location _____

Rig up _____

Drilling and Remarks:

Lease 30057" C 29983000 acidPump 39237 1/2 G

RECORD

Cased _____ in., _____ ft.

Sand _____

Gas _____

Oil _____

Total Depth 3032

PRODUCTION

1st 24 hrs. Nat. _____

1st 24 hrs. after shot _____

Gas _____ Cu. Ft.

Dry Hole _____

Abandoned _____

Date

OCT 27 1943 19S. J. LEWIS Scout