

County Saline Elev. _____				Co.
Sec. 3 Twp. 15 Rge. 1W				
Company Rex & Morris & NCRA				
FarmName Rack No. 1				
TOPS	DEPTH	LOG	DATUM	Loc. in Sec.
Anh.				SE SE SE
TP.				
H.				
Tr.				
Dg.				Miss. test
Bl.				
L.				Geol. _____
K.C.				Contr. _____
B.K.C.				Rex & Morris
Ce.				
C.				Pool _____
M.				Wildcat
M.				
K.				
Mz.				
Me.				
V.				
S.				
S.				
A.				
R.				
PE.				
G.				
TD.				
Date Comm. _____				No.
Location				
				Sec.
				T.
				R.

FIRST REPORT
 SEP 14 1955

County Saline Elev. 1219				Co.
Sec. 3 Twp. 15 Rge. 1W				
Company Rex & Morris & NCRA				
FarmName Peck No. 1				
TOPS	DEPTH	LOG	DATUM	Loc. in Sec.
Anh.				SE SE SE
TP.				
H.	1645		426	
Tr.				
Dg.	1754		535	
Bl.				
L.	1880		661	Geol. _____
K.C.				Contr. _____
B.K.C.				Rex & Morris
Ce.				
C.				Pool _____
M.	2538		1319	Wildcat
M.				
K.				
Mz.				
Me.				
V.				
S.				
S.				
A.				
R.				
PE.				
G.				
TD.	2015			
Date Comm. 9-21-55				No.
8 5/8" @ 123/95 DST 2539-45 open 1 hr				
Rec. 60' mud SSO				Sec.
				T.
D & A				
				R.

ABANDONED
 SEP 28 1955

Saline KANSAS

SEC. 3 TWP. 15 R. 1W


WELL NO. #1 Peck FARM

COMPANY Rex & Morris & NCRA

CONTRACTOR Rex & Morris

WILDCAT

_____ Ft. from N. Line
 _____ Ft. from S. Line
 _____ Ft. from E. Line
 _____ Ft. from W. Line

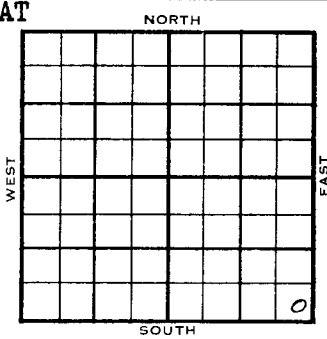

SE SESE
~~SE SE SE~~

1955 ELEVATION 1219 REPORT

9-14 Location Miss. test
 9/28 8 Comm 9-21-55
 8 5/8" @ 123/95
 H 1645
 Dg 1754
 L 1880
 M 2538
 TD 2615
 DST 2539-45 open 1 hr Rec 60' mud
 SSO D & A

ABANDONED

Saline KANSAS

DX 78-1

Section 3 Township 15 Range 1 W

Well No. #1 Peck

Company Rex & Morris & NCRA

