

Pool Name Wildcat

Map No. 42 Sec. 7 Twp. 15 R. 1W

Well No. 1 Swan

Phillips Company

FIRST REPORT

Contractor

NE NW

SECTION PLAT

330 Ft. from N. Line

_____ Ft. from S. Line

330 Ft. from E. Line

_____ Ft. from W. Line

		o	

Saline County

Location X

Rig up _____

Drilling and Remarks:

RECORD

Cased _____ in., _____ ft.

Sand _____

Gas _____

Oil _____

Total Depth _____

PRODUCTION

1st 24 hrs. Nat. _____

1st 24 hrs. after shot _____

Gas _____ Cu. Ft.

Dry Hole _____

Abandoned _____

Date

MAY 24 1944 19

S. J. LEWIS Scout

Pool Name Wildcat

Map No. 42 Sec. 7 Twp. 15 R. 1W

Well No. 1 Swan

Phillips Company

ABANDONED

Contractor

NE NW

SECTION PLAT

330 Ft. from N. Line

_____ Ft. from S. Line

330 Ft. from E. Line

_____ Ft. from W. Line

		o	

Saline County

Location _____

Rig up _____

Drilling and Remarks:








RECORD

Cased _____ in., _____ ft.

Sand _____

Gas _____

Oil _____

Total Depth 3487

PRODUCTION

1st 24 hrs. Nat. _____

1st 24 hrs. after shot _____

Gas _____ Cu. Ft.

Dry Hole _____

Abandoned _____

Date

JUL 12 1944 19

S. J. LEWIS Scout

Saline

Sec. 7 Twp. 15 R. 1W

Well No. #1 Swan Farm
Phillips Company

Wildcat


330 Ft. from N. Line

Ft. from S. Line

330 Ft. from E. Line

Ft. from W. Line

Elev. 1247

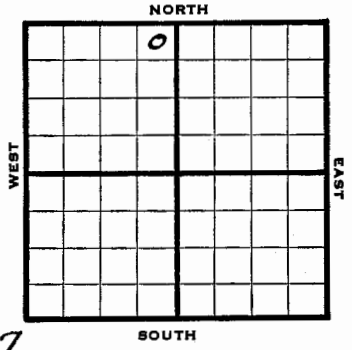

1944

REPORT

5/24 Location

5/31 "

6/7 Rotary

6/15 8" @ 135
Drlg 2400

6/21 Drlg. 2313

6/28 Drlg 3481

7/12 Lans 2017
Miss 2678
Misener 3040
Hanton 3050
Viola 3286
Simp 3373
Arb 3451
TD 3481

ABANDONED

Saline

Section 7 Township 15 Range 1W

Well No. #1, Swan

Company Phillips

