

Saline

KANSAS
Map No. 42 Sec. 10 Twp. 15 R. 1W

Well No. 1 Currie

Phil-Han _____ Company

FIRST REPORT _____ Contractor

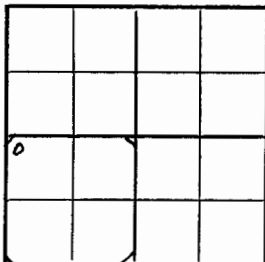
NW SW

SECTION PLAT

330 Ft. from N. Line

_____ Ft. from S. Line

_____ Ft. from E. Line

330 Ft. from W. Line

WILDCAT

Location _____

Rig up _____

Drilling and Remarks:

8"-115'

Anhy. 225'

Drlg. 1952'

RECORD

Cased _____ in., _____ ft.

Sand _____

Gas _____

Oil _____

Total Depth _____

PRODUCTION

1st 24 hrs. Nat. _____

1st 24 hrs. after shot _____

Gas _____ Cu. Ft.

Dry Hole _____

Abandoned _____

Date

JUN 2 1943 19 S. J. LEWIS Scout

Saline

KANSAS
Map No. 42 Sec. 10 Twp. 15 R. 1W

Well No. 1 Currie

Phil-Han _____ Company

ABANDONED _____ Contractor

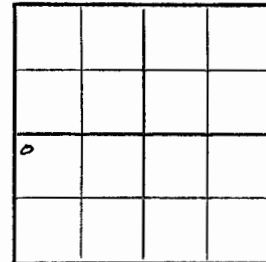
NW SW

SECTION PLAT

330 Ft. from N. Line

_____ Ft. from S. Line

_____ Ft. from E. Line

330 Ft. from W. Line

WILDCAT

Location _____

Rig up _____

Drilling and Remarks:

*Smip 3222**V. R. 3167**Cu Y 3333**Noe hole*

RECORD

Cased _____ in., _____ ft.

Sand _____

Gas _____

Oil _____

Total Depth 3363

PRODUCTION

1st 24 hrs. Nat. _____

1st 24 hrs. after shot _____

Gas _____ Cu. Ft.

Dry Hole _____

Abandoned _____

Date

JUN 1 6 1943 19 S. J. LEWIS Scout

Saline

KANSAS

Sec. 10 Twp. 15 R. 1-W

Well No. #1 Currie Farm

Phil-Han Company

Wildcat

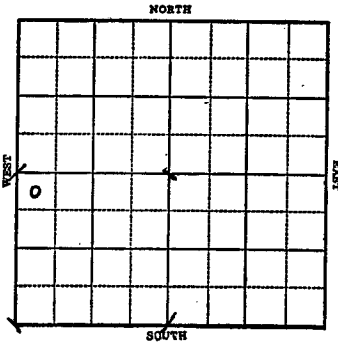
330 Ft. from N. Line

 Ft. from S. Line

 Ft. from E. Line

330 Ft. from W. Line

Elev. 1207



1943

REPORT

6/2 8" @ 115'
Anhy 225'
Drlg. 1952'

6/9 Miss 2577
D. Miss 2788
Hunton 2910
Drlg. 3150'

6/16 Simp 3222
Viola 3167
Arb. 3333
T.D. 3363
No shows.

ABANDONED

KANSAS

Saline

Section 10 Township 15 Range 1-W

Well No. #1 Currie

Company Phil-Han

