


KANSAS
 Map No. 42 Sec. 12 Twp. 15 R. 1W
 Well No. 1 Robson

E. T. Lindsey et al. Company
FIRST REPORT Contractor

SE NE NE

SECTION PLAT

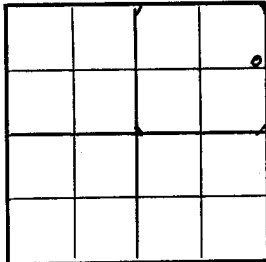

990 Ft. from N. Line
 _____ Ft. from S. Line
330 Ft. from E. Line
 _____ Ft. from W. Line

Wildcat

Location _____

Rig up _____

Drilling and Remarks:

Machine

RECORD

Cased _____ in., _____ ft.
 Sand _____
 Gas _____
 Oil _____
 Total Depth _____

PRODUCTION

1st 24 hrs. Nat. _____
 1st 24 hrs. after shot _____
 Gas _____ Cu. Ft.
 Dry Hole _____
 Abandoned _____

Date


SEP 22 1943 19 S. J. LEWIS Scout

Map No. 42 Sec. 12 Twp. 15 R. 1W
 Well No. 1 Robson

E. T. Lindsey et al. Company
ABANDONED Contractor

SE NE NE

SECTION PLAT

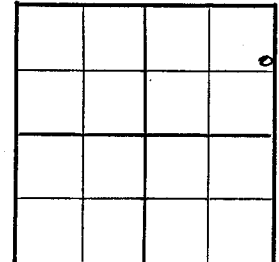

990 Ft. from N. Line
 _____ Ft. from S. Line
330 Ft. from E. Line
 _____ Ft. from W. Line

Wildcat

Location _____

Rig up _____

Drilling and Remarks:

Miss 2618.7" @ 2650Wanted

RECORD

Cased _____ in., _____ ft.
 Sand _____
 Gas _____
 Oil _____
 Total Depth 2658

PRODUCTION

1st 24 hrs. Nat. _____
 1st 24 hrs. after shot _____
 Gas _____ Cu. Ft.
 Dry Hole _____
 Abandoned _____

Date

JAN 12 1944 19 S. J. LEWIS Scout

KANSAS

Saline

Sec. 12 Twp. 15 R. 1-W

Well No. #1 Robson Farm


E. T. Lindsay etal Company

990 Ft. from N. Line

Ft. from S. Line

330 Ft. from E. Line

Ft. from W. Line

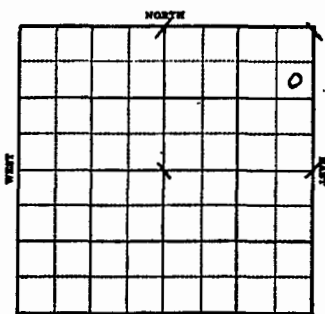

Elev. 1354

1943

12/29

PB 2622

1 shot 2620 250' oil 1 hr

20 shots 2620-21

1000 acid

1944

1-5

SD

1/12

7" @ 2650

Miss 2618

TD 2658

Water

ABANDONED

1943	REPORT
9/22	Machine
9/29	"
10/6	"
10/13	"
10/20	"
10/27	"
11/3	"
11/10	" pud
11/17	15" @ 410' Drlg. 855'
11/24	Drlg. 1720 12" @ 1386'
12/1	10" @ 1962 Lans 1990 Drlg 2140'
12/8	10" @ 1290 Drlg. 2283'
12-15	Miss 2618-19 1/2 TD 7" at 2580' 350 oil
12/22	HFW 2650 Drlg. 2658'
OVER	

Section 12 Township 15 Range 1-W

Well No. #1 Robson

Company E. T. Lindsay et al

