

County ~~Saline~~ Elev. _____
 Sec. 16 Twp. 15 Rge. 1W
 Company Rex & Morris & NCRA
 FarmName Major No. 1

TOPS	DEPTH	LOG	DATUM	Loc. in Sec.
				<u>SW SW NE</u>
				<u>Miss. test</u>
				Geol. _____
				Contr. _____
				<u>Rex & Morris</u>
				Pool _____
				<u>Wildcat</u>
				<div style="border: 1px dashed black; padding: 5px; text-align: center;"> FIRST REPORT SEP 4 1955 </div>

Date Comm. _____
 Location _____

County ~~Saline~~ Elev. 1209
 Sec. 16 Twp. 15 Rge. 1W
 Company Rex & Morris & NCRA
 FarmName Major No. 1

TOPS	DEPTH	LOG	DATUM	Loc. in Sec.
				<u>SW SW NE</u>
	<u>1732</u>		<u>523</u>	
	<u>1768</u>		<u>559</u>	
	<u>1873</u>		<u>604</u>	
	<u>1937</u>		<u>722</u>	
	<u>2281</u>		<u>1072</u>	
	<u>2587</u>		<u>1380</u>	
	<u>2641</u>			

Date Comm. 9-11-55 SEP 28 1955
8 5/8" @ 158/95
 D & A

Saline KANSAS,


SEC. 16 TWP. 15 R. 1W

WELL NO. #1 Major FARM

COMPANY Rex & Morris & NCRA

CONTRACTOR Rex & Morris

WILDCAT

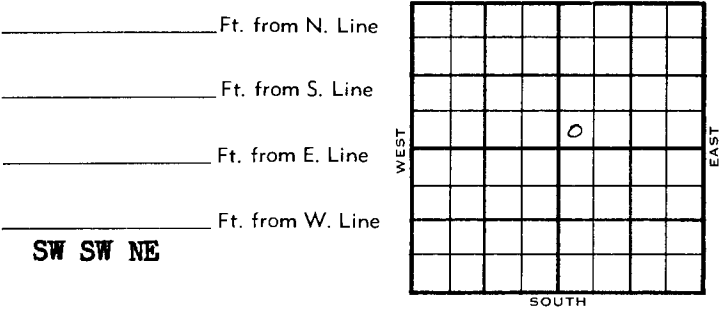

	ELEVATION	REPORT
1955	1209'	
9-14	Location	Miss. test
9/28	Comm 9-14-55	
	8 5/8" @ 158/95	
	H	1732
	Dg sd	1768
	B1	1873
	L	1931
	BKC	2281
	M	2589
	TD	2641
	D& A	
ABANDONED		

DX-78

DX 78-1

Saline KANSAS

Section 16 Township 15 Range 1 W

Well No. #1 Major

Company Rex & Morris & NCRA

