

Top Pool
Bottom Pool 44

SECTION 19 TOWNSHIP 15S RANGE 1W


WELL NO. #1 Shoffner

COMPANY Ohio Oil Co.

S-513-B

County Saline Elev. _____
Sec. 19 Twp. 15 Rge. 1W
Company Ohio Oil Co.
Farm Name Shoffner No. 1

TOPS	DEPTH	LOG	DATUM	Loc. in Sec.
Anh.				C SE NW
Tp.				
H.				
Tr.				
Dg.				
B. L.				Geol.
L.				Contr.
K.C.				GREENLAND #1
B.K.C.				Pool
Ce.				Wildcat
C.				
M.				
M.				
K.				
Mz.				
Mq.				
V.				
S.				
S.				
A.				
R.				
Pf.				
G.				
T.D.				

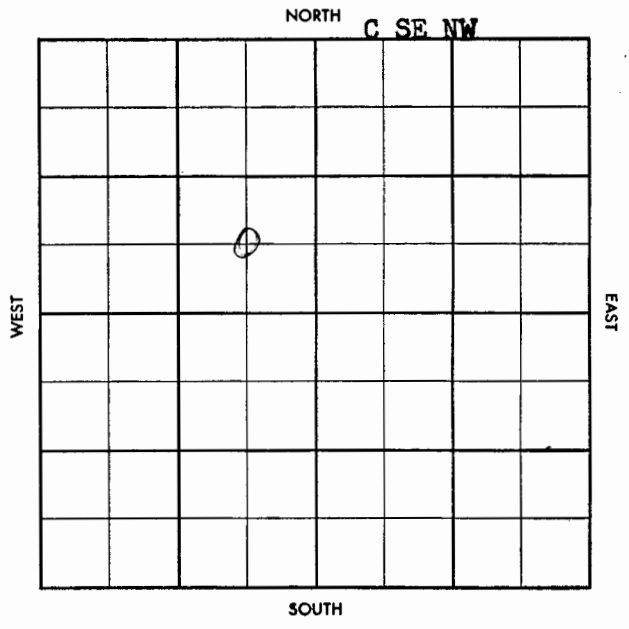

Date Comm. 8-18-58
9" @ 202 w/150, Drlg. 610

No No
~~No No~~

15A

S-513-B

County Saline Elev. 1349 OF 135200
 Sec. 19 Twp. 15 Rge. 1W
 Company Ohio Oil Co.
 Farm Name Shoffner No. 1

TOPS	DEPTH	LOG	DATUM	Loc. in Sec.
Anh.				
Tp.	1620			0 SE 1/4
M.	1901	1902		
Tr.	1928			
Dg. <u>sd</u>		1911		
B.L.	2082	2051		
L.	2120	2122		
K.C.				Geol.
B.K.C.				Contr.
Co.				<u>GREENLAND #1</u>
C.				Pool
M.	2774	2788		<u>Wildcat</u>
M.				<div style="border: 1px solid black; padding: 5px; text-align: center;"> ABANDONED 0 SEP 3 '58 </div>
K.				
Mz.	3173	3173		
Mq. <u>Munt</u>	3179	3184		
v. <u>770</u>		3209		
S. <u>V</u>		3402		
S. <u>sd</u>		3509		
A.		3569		
R.				
Pf.				
G.				
T.D.	3616			

Date Comm. 8-18-58
9" - 202 w/150, Drlg. 610 AUG 27 '58 @ 2885
SEP 3 '58 DST 3172-93 1A 300'SW
65'M FP 30-170 BHP 1215/30"

D&A