


Map No. _____ Sec. 34 Twp. 15 R. 1WWell No. 1 KarberR. J. Wilson Company**FIRST REPORT**

Contractor

SE SW

SECTION PLAT

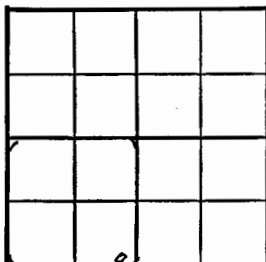

_____ Ft. from N. Line

330 Ft. from S. Line330 Ft. from E. Line

_____ Ft. from W. Line

Saline County

Location _____

Rig up _____

Drilling and Remarks:

Rig _____

RECORD

Cased _____ in., _____ ft.

Sand _____

Gas _____

Oil _____

Total Depth _____

PRODUCTION

1st 24 hrs. Nat. _____

1st 24 hrs. after shot _____

Gas _____ Cu. Ft.

Dry Hole _____

Abandoned _____


Date

MAR 5 1947 19S. J. LEWIS ScoutMap No. 42 Sec. 34 Twp. 15 R. 1WWell No. 1 KarberR. J. Wilson Company**ABANDONED**

Contractor

SE SW

SECTION PLAT

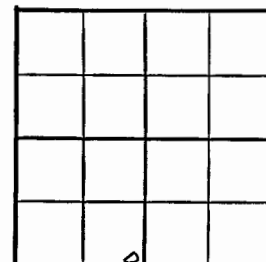

_____ Ft. from N. Line

330 Ft. from S. Line330 Ft. from E. Line

_____ Ft. from W. Line

Saline County

Location _____

Rig up _____

Drilling and Remarks:

Miss 2605.
5" @ 2700

RECORD

Cased _____ in., _____ ft.

Sand _____

Gas _____

Oil _____

Total Depth 2700

PRODUCTION

1st 24 hrs. Nat. _____

1st 24 hrs. after shot _____

Gas _____ Cu. Ft.

Dry Hole _____

Abandoned _____

Date

OCT 1 1947 19S. J. LEWIS Scout

KANSAS

Saline ✓

Sec. 34 Twp. 15 R. 1-W

Well No. #1 Karber Farm

R. J. Wilson Company


Wildcat

Ft. from N. Line

330 Ft. from S. Line

330 Ft. from E. Line

Ft. from W. Line

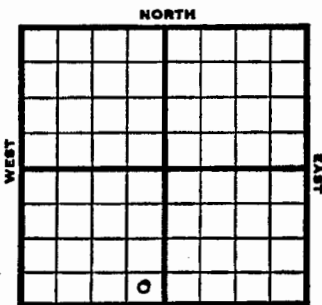

SE SW Elev. 1231'

REPORT

1947

3/5 Rig
3/11 Spud
3/18 15" @ 80'
Drlg 485'
3/25 12" @ 682'
Drlg 740'
4/2 12" @ 757'
Drlg. 955'.
4/9 Drlg 1385'
4/15 Drlg. 1385'
4/23 SD
4/29 10" @ 1405'
8" @ 1988'
Drlg 2350'
5/7 SD
5/13 6" @ 2400'
Mississippi 2605'
Drlg. 2660'
5/20 " "

OVER

5/27 Drlg. 2660'

6/3 TD 2700
Run osg.

6/10 " "

6/17 " "

6/24 " "

7/1 " "

7/8 " "

7-16 " "

7/22 " "

7/29 " "

8/6 " "

8/13 " "

8/20 " "

8/27 " "

9/3 " "

9/10 " "

9/17 " "

9/24 " "

10/1 Miss 2605
5" @ 2700
TD 2700

ABANDONED

Saline County

Wildcat

FORM 51 IOM 12-46 PETROL

KANSAS

Section 34 Township 15 Range 1W

Well No. 1 Karber

Company R. J. Wilson

