

County **Ellsworth** State **Kansas**
 Sec. **1** (Blk. Twp.) **15** (Sur. Rge.) **10W** Map No.
 Operator **B & B Drlg.**
 Well No. **1** Farm **Mattas**
 Elev. **1614** Location **NW 1/4 NW 1/4**

0							

330 Ft. From **N** Line **NW**
330 Ft. From **W** Line **Quarter**
 1st. Report **NOV 29 1950**
 Completion
 Remarks **B & B Drlg. - Contr.**
 Spudding Date **11-26-50**
 Drlg. Data **Wildcat**
drlg.

J. E. TYRA


County **Ellsworth** State **Kansas**
 Sec. **1** (Blk. Twp.) **15** (Sur. Rge.) **10W** Map No.
 Operator **B & B Drlg.**
 Well No. **1** Farm **Mattas**
 Elev. **1614** Location **NW 1/4 NW 1/4**

0							

330 Ft. From **N** Line **NW**
330 Ft. From **W** Line **Quarter**
 1st. Report
 Completion **DEC 13 1950**
 Remarks **Wildcat**
B & B Drlg. - Contr.
 Spudding Date **11-26-50**
 Drlg. Data **D & A** **TD 3120**
3" C 200 Top. **2338** Heeb. **2592**
 Dodge **2611** Douglas **2623** Br. lime **2693**
 Lens. **2713** DST **2736-41** open $\frac{1}{2}$ hr.
 Rec. **10'** mud Cong. **3055** ReArb. **3065**
 Arb. **3078-3120** TD
D & A


J. E. TYRA

County Ellsworth State Kansas
 Sec. 1 (Blk. Twp.) 15 (Sur. Rge.) 10W Map No.
 Operator B & B Drlg.
 Well No. 1 Farm Mattas
 Elev. 1614 Location NW NW NW
 330 Ft. From N Line NW
 330 Ft. From W Line Quarter
 1st. Report NOV 29 1950
 Completion
 Remarks B & B Drlg. - Contr.
 Spudding Date 11-26-50
 Drlg. Data Wildcat
drlg.

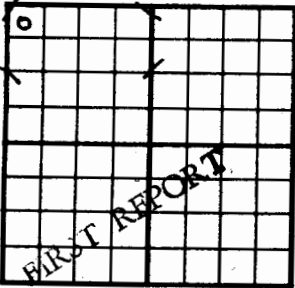

J. E. TYRA

County Ellsworth State Kansas
 Sec. 1 (Blk. Twp.) 15 (Sur. Rge.) 10W Map No.
 Operator B & B Drlg.
 Well No. 1 Farm Mattas
 Elev. 1614 Location NW NW NW
 330 Ft. From N Line NW
 330 Ft. From W Line Quarter
 1st. Report
 Completion DEC 13 1950
 Remarks Wildcat
B & B Drlg. - Contr.
 Spudding Date 11-26-50
 Drlg. Data D & A TD 3120
8" @ 200 Top. 2338 Heeb. 2592
Dodge 2611 Douglas 2623 Br. lime 2693
Lans. 2713 DST 2736-41 open 1/2 hr.
Rec. 10' mud Cong. 3055 ReArb. 3065
Arb. 3078-3120 TD
D. & A

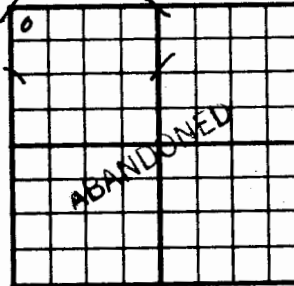

J. E. TYRA

Ellsworth KANSAS

Sec. 1 Twp. 15 R. 10W

Well No. #1 Mattas Farm

B & B Drlg. Company

B & B Drlg. - Contr. Contractor


330' Wildcat
Ft. from N. Line

Ft. from S. Line

Ft. from E. Line

330' Ft. from W. Line

NW NW NW

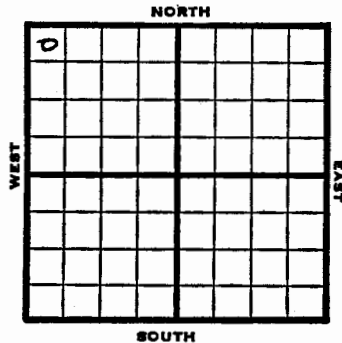


Ellsworth KANSAS

Section 1 Township 15 Range 10W

Well No. #1 Mattas

Company B & B Drlg.

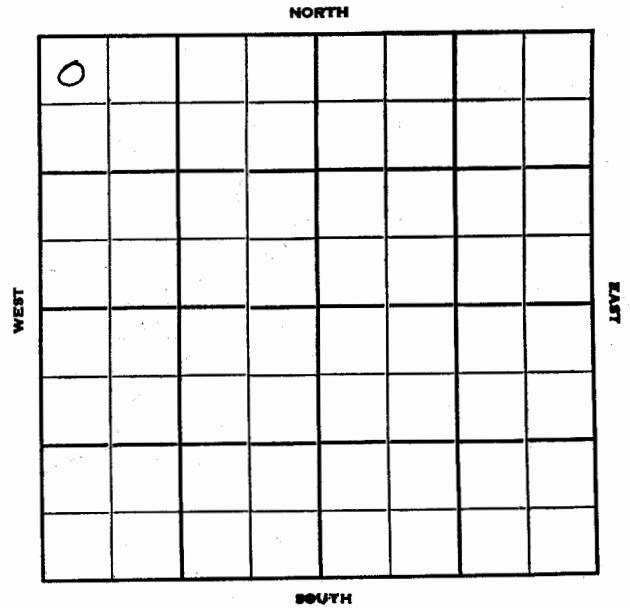

1950 Elev. 1614' REPORT

11/29 Spud 11-26-50
Drlg.

12/13 Spud 11-26-50
D&A TD 3120
8" @ 200' Top. 2338'
Heeb. 2592' Dodge 2611
Douglas 2623' Br. Lime 2693
Lans. 2713'
DST 2736-41 opn 1/2 hr
Rec. 10' mud Cong. 3055
ReArb. 3065 Arb. 3078-3120 TD
D&A **ABANDONED**