


County Ellsworth State Kansas
 Sec. 7 (Blk. 15 (Sur. 10W Map No.
 Operator Lindsley Drlg.
 Well No. 1 Farm Branda
 Elev. _____ Location SE SE SE

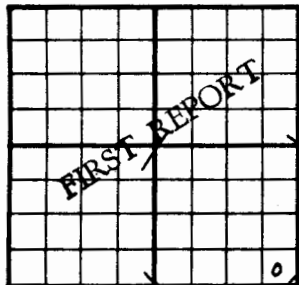


330 Ft. From S Line SE
330 Ft. From E Line Quarter
 Ist. Report SEP 19 1951
 Completion _____
 Remarks _____
 Spudding Date 9-13-51

Drlg. Data

8" @ 249 Anhy 560 Drlg. 2315

J. E. TYRA

County Ellsworth State Kansas
 Sec. 7 (Blk. 15 (Sur. 10W Map No.
 Operator Lindsley Drlg.
 Well No. 1 Farm Branda
 Elev. 1715 Location SE SE SE

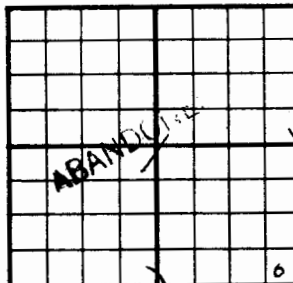

330 Ft. From S Line SE
330 Ft. From E Line Quarter
 Ist. Report _____
 Completion SEP 26 1951
 Remarks _____
 Spudding Date 9-13-51

Drlg. Data D & A TD 3312

8" @ 249 Anhy 560 Heeb. 2769

Br. lime 2861 Lens. 2882 Simp. sh. 3227

Simp. sd. 3239 Arb. 3275 TD 3312

D & A

J. E. TYRA

Ellsworth KANSAS

Sec. 7 Twp. 15 R. 10W

Well No. #1 Branda Farm

Lindsley Drlg. Company

Contractor


Ft. from N. Line

330' Ft. from S. Line

330' Ft. from E. Line

Ft. from W. Line

SE SE SE

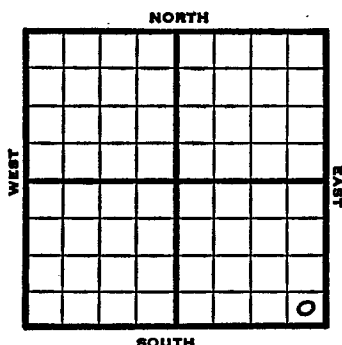

1951 Elev. 1715' REPORT

9/19 Spud 9-13-51
8" @ 249
Anhy 560
Drlg. 2315'

9/26 Spud 9-13-51
D & A TD 3312
8" @ 249
Anhy 560 Heeb. 2769 Br. Im. 2861
Lans. 2882 Simp. Sh. 3227
Simp. Sd. 3239 Arb. 3275
TD 3312' D&A

ABANDONED

Section 7 Township 15 Range 10 W

Well No. # 1 Branda

Company Lindsley Drlg.

