

KANSAS Kansas Pool Name Wildcat

Map No. 55 Sec. 19 Twp. 15 R. 10W

Well No. 1 Hoch

Goff Davis etal. Company

FIRST REPORT Contractor

SE SW NW


SECTION PLAT

_____ Ft. from N. Line

330 Ft. from S. Line

_____ Ft. from E. Line

990 Ft. from W. Line

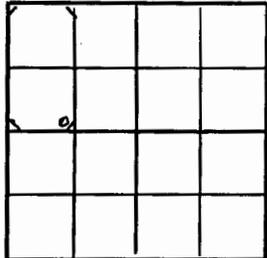

Ellsworth County

Location _____

Rig up _____

Drilling and Remarks:

8" @ 201
Anhy 645
Dr1g 2542

RECORD

Cased _____ in., _____ ft.
Sand _____
Gas _____
Oil _____
Total Depth _____

PRODUCTION

1st 24 hrs. Nat. _____
1st 24 hrs. after shot _____
Gas _____ Cu. Ft.
Dry Hole _____
Abandoned _____

Date

APR 1 0 1946 19 S. J. LEWIS Scout

KANSAS Kansas Pool Name Wildcat

Map No. 55 Sec. 19 Twp. 15 R. 10W

Well No. 1 Hoch

Goff Davis etal. Company

ABANDONED Contractor

SE SW NW


ELIHO
SECTION PLAT

_____ Ft. from N. Line

330 Ft. from S. Line

_____ Ft. from E. Line

990 Ft. from W. Line

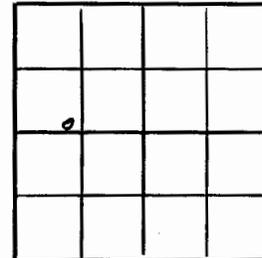

Ellsworth County

Location _____

Rig up _____

Drilling and Remarks:

Line 287
8103270
Express

RECORD

Cased _____ in., _____ ft.
Sand _____
Gas _____
Oil _____
Total Depth 3350

PRODUCTION

1st 24 hrs. Nat. _____
1st 24 hrs. after shot _____
Gas _____ Cu. Ft.
Dry Hole _____
Abandoned _____

Date

APR 1 7 1946 19 S. J. LEWIS Scout

O.W.W.O

FORM 513 REV. SUNRAY

ONWO

County **Ellsworth** Elev. **10W**
 Sec. **19** Twp. **15** Rge. **10W**
 Company **Gough W. Davis**
 FarmName **Hoch** No. **1**

TOPS	DEPTH	LOG	DATUM	Loc. in Sec.
Anh.				SE SW NW
TP.				
H.				
Tr.				
Dg.				
BL.				
L.				
K.C.				
B.K.C.				
Ce.				
C.				
M.				
M.				
K.				
Mz.				
Me.				
V.				
S.				
S.				
A.				
R.				
PE.				
G.				
TD.				

Geol. _____
 Contr. **Lewis**
 Pool **Wildcat**

FIRST REPORT	
of	
NOV 9 '51	

Date Comm. **OTD 3350'**
Location

FORM 513 REV. SUNRAY

ONWO

County **Ellsworth** Elev. **1805**
 Sec. **19** Twp. **15** Rge. **10W**
 Company **Gough W. Davis**
 FarmName **Hoch** No. **1**

TOPS	DEPTH	LOG	DATUM	Loc. in Sec.
Anh.				SE SW NW
TP.				
H.	2830		1025	
Tr.				
Dg.				
BL.				
L.	2957		1152	
K.C.				
B.K.C.	3270		1465	
Ce.				
C.	3314		1509	
M.				
M.				
K.				
Mz.				
Me.				
V.				
S.				
S.				
A.	3325		1520	
R.				
PE.				
G.				
TD.	3350			

Geol. _____
 Contr. **Lewis**
 Pool **Wildcat**

ABANDONED	
of	

Date Comm. **NOV 16 1955**
OTD 3350 CO DD 3352 DST 3331-52

open 1 hr. rec. 920' sw 1005/20"

DST 3323-31 open 2 hr. rec. 90'

so & gcm 625"

D & A

7.W.110

FORM 513 REV. SUNRAY

OWWO

County **Ellsworth** Elev. _____
 Sec. **19** Twp. **15** Rge. **10W**
 Company **Gough Davis**
 Farm Name **Hoch** No. **1**

TOPS	DEPTH	LOG	DATUM	Loc. in Sec.												
Anh.				SE SW NW												
Tr.																
H.																
Tr.																
Dg.																
Bl.																
L.	2957			Geol. _____												
K.C.				Contr. _____												
B.K.C.				Lewis Drlg.												
Ce.				Pool _____												
C.				Wildcat												
M.																
M.																
K.																
Mz.																
Mo.																
V.																
S.																
S.	3323			<table border="1"> <tr><td></td><td></td><td></td></tr> <tr><td></td><td></td><td></td></tr> <tr><td></td><td></td><td></td></tr> <tr><td></td><td></td><td></td></tr> </table>												
A.																
R.																
Pe.																
G.																
T.D.	3351															

Date Comm. _____
DST 3334-51 open 1 hr. rec. 900' sw
1000# DST 3323-32 open 1 hr. rec.
90' socm 605# to run pipe

FORM 513 REV. SUNRAY

OWWO

County **Ellsworth** Elev. **1805**
 Sec. **19** Twp. **15** Rge. **10W**
 Company **Gough Davis**
 Farm Name **Hoch** No. **1**

TOPS	DEPTH	LOG	DATUM	Loc. in Sec.												
Anh.				SE SW NW												
Tr.																
H.																
Tr.																
Dg.																
Bl.																
L.	2957			Geol. _____												
K.C.			1152	Contr. _____												
B.K.C.				Lewis Drlg.												
Ce.				Pool _____												
C.				Wildcat												
M.																
M.																
K.																
Mz.																
Mo.																
V.																
S.																
S.				<table border="1"> <tr><td></td><td></td><td></td></tr> <tr><td></td><td></td><td></td></tr> <tr><td></td><td></td><td></td></tr> <tr><td></td><td></td><td></td></tr> </table>												
A.	3323		1578													
R.																
Pe.																
G.																
T.D.	3351															

Date Comm. **JAN 11 1956**
DST 3334-51 open 1 hr. rec. 900' sw
1000# DST 3323-32 open 1 hr. rec.
90' socm 605# 4 1/2" @ 3351 CO to 3340
6/ 3324-25 250 A FU 2700' wtr. 16 hr
D & A

O.W.W.O. 11-19-55 KANSAS O.W.W.O. 12-21-55 Ellsworth County

Sec. 19 Twp. 15 R. 10W

Well No. #1 Hook Farm

Gough W. Davis

Wildcat (Contz - Lewis) Company


Ft. from N. Line

330 Ft. from S. Line

Ft. from E. Line

990 Ft. from W. Line

SE SW NW

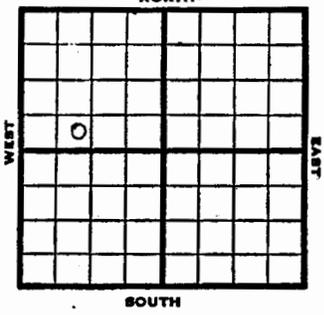

1946	Elev. 1805	REPORT
4/10	8" @ 201 Anhy 645' Drlg. 2542'	
4/17	Lens 2957 BKC 3270 Arb. 3323 TD 3350'	
1955	Location	ABANDONED O.W.W.O.
11-16	OTD 3350 CO DD 3352 DST 3334-52 op 1 hr. rec. 920' sw 1005/20" DST 3323-31 op 2 hrs. rec. 90' so&gcm 625# D&A, TD3352' H. 2830 L. 2957 B.K.C. 3270 C. 3314 A 3325	ABANDONED OVER

1955
12/ 21

O.W.W.O.

OTD 3351'
DST 3334-51, open 1 hr rec 900'
SW, 1000#
DST 3323-32, open 1 hr rec 90' SOCM
605#. To run pipe.
L. 2957', A. 3323'
TD 3351'

1956

1-11 4 1/2" @ 3351
CO to 3340
6/ 3324-25, 250 A
FU 2700' wtr., 16 hrs.,
D & A
KC. 2957
A. 3323
TD 3351'

ABANDONED

O.W.W.O. 11-19-55

FORM 11-55 11-44 PETROL

KANSAS Ellsworth county

O.W.W.O. 12-21-55

Section 19 Township 15 Range 10W

Well No. #1, Hock

Company Gough W. DAVIS
~~Cozz Davis et al~~

