

County	Ellsworth	Elev.	1791
Sec.	19	Twp.	15
Rgs.	LOW		
Company	Birmingham & Bartlett		
Farm Name	V. Hoch	No.	1

TOPS	DEPTH	LOG	DATUM	Loc. in Sec.
Anh.				SE NE NW
TP.				
H.				
Tr.				
Dg.				
Bl.				
L.				
K.C.				Geol.
B.K.C.				Contr.
Ce.				Co. tools
C.				
M.				Pool
M.				Wildcat
K.				
Mz.				
Me.				
V.				
S.				
S.				
A.				
R.				
Pe.				
G.				
TD.				

Date Comm. 3-15-56

8" @ 367/200 d.l.g. 2691

County	Ellsworth	Elev.	1791
Sec.	19	Twp.	15
Rgs.	LOW		
Company	Birmingham & Bartlett		
Farm Name	V. Hoch	No.	1

TOPS	DEPTH	LOG	DATUM	Loc. in Sec.
Anh.	627			SE NE NW
TP.				
H.	2836			
Tr.				
Dg.				
Bl.				
L.	2948		1157	Geol.
K.C.				Contr.
B.K.C.				Co. tools
Ce.				
C.				Pool
M.				Hoch
M.				
K.				
Mz.				
Me.				
V.				
S.				
S.				
A.	3301		1510	
R.				
Pe.				
G.				
TD.	3315			

Date Comm. 3-15-56 JUN 20 1956

8" @ 367/200 DST 3029-68 open 1 hr.

rec. 150' mud 840# DST 3302-05

open 1½ hr. rec. 300' muddy oil & SSW

825# 5½" @ 3304 CO to 3305

S/ 2 bo 2 bw 2 hr. FU 400' oil

300' wtr. 12 hr. P/ 5 bopd 30 bw

P/ 6½ bopd 18 bw P/ 5 bopd 22 bw

11 days P/ 3 bo 23 bw 24 hr.

Comp. 3 bopd 45 bw

Ellsworth

KANSAS

SEC. 19	TWP. 15	R. 10W
------------	------------	-----------

WELL NO.

#1 V. Hock

FARM

COMPANY

Birmingham & Bartlett

CONTRACTOR

Co. Tools

WILDCAT


Ft. from N. Line

Ft. from S. Line

Ft. from E. Line

Ft. from W. Line

SE NE NW

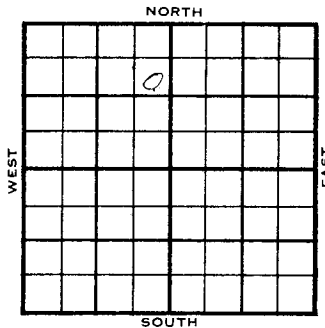

1956

ELEVATION

1791'

REPORT

3-21

Comm. 3-15-56

8" @ 367/200

Drlg. 2691

6-20

DST 3029-68, op 1 hr, rec 150' mud

BHP 840#

DST 3302-05, op 1½ hr, rec 300' muddy oil & ssw

BHP 825#

5½" @ 3304

CO to 3305

S/ 2 bo, 2 bw/ 2 hrs.

FU 400' oil, 300' wtr./ 12 hrs.

P/ 5 bopd, 30 bw

P// 6½ bopd, 18 bw

P// 5 bopd, 22 bw, ~~11 days~~ 11 days

P/ 3 bo, 23 bw/ 24 hr.

Comp. 3 bopd, 45 bw

anh. 627', H. 2836', L. 2938',

A. 3301',

TD 3305'

COMPLETED

DX-78

DX 78-1 Ellsworth

KANSAS

Section 19	Township 15	Range 10W
---------------	----------------	--------------

Well No. #1 V. Hock

Company Birmingham & Bartlett

