

Map No. _____ Sec. 21 Twp. 15 R. 10W
 Well No. 1 D. A. Oeser
 National Assoc. Pet. _____ Company
 Brunson Drlg. _____ Contractor
 SW SW NW

SECTION PLAT



_____ Ft. from N. Line
330 Ft. from S. Line
 _____ Ft. from E. Line
330 Ft. from W. Line
 Ellsworth County

Location _____
 Rig up _____
 Drilling and Remarks:

Spud 7-16-50
 8" @ 334
 drlg. 1070

RECORD

Cased _____ in., _____ ft.
 Sand _____
 Gas _____
 Oil _____
 Total Depth _____

PRODUCTION

1st 24 hrs. Nat. _____
 1st 24 hrs. after shot _____
 Gas _____ Cu. Ft.
 Dry Hole _____
 Abandoned _____

Date

JUL 19 1950

J. E. TYRA

19

Scout

County Ellsworth State Kansas
 Sec. 21 (Blk. Twp.) 15 (Sur. Rge.) 10W Map No. _____
 Operator National Assoc. Pet.
 Well No. 1 Farm D. A. Oeser
 Elev. 1801 Location SW SW NW
330 Ft. From S Line NW
330 Ft. From W Line Quarter
 1st. Report _____
 Completion AUG 9 1950
 Remarks _____
 Spudding Date 7-16-50

Drlg. Data

Wildcat

8" @ 334 Top. 2528 DST 2655-2703
 open 1 hr. Rec. 120' sw Heeb. 2861
 Toronto 2882 Br. lime 2930 DST 2972-87
 open 1 hr. Rec. 10' socm DST 3028-43
 open 1 hr. Rec. 145' mud & water
 DST 3045-46 Rec. 60' sw DST 3086-3132
 open 1 hr. Rec. 6' mud DST 3129-56
 open 1 hr. Rec. 85' mud DST 3156-91
 open 1 hr. Rec. 7' mud Cong. 3296
 Simp. 3340 Arb. 3349 DST 3353-57
 open 1 hr. Rec. 2345' sw DST 3370-3421
 open 1 hr. Rec. 2150' water TD 3421

D & A

J. E. TYRA

KANSAS Ellsworth

Sec. 21 Twp. 15 R. 10-W

Well No. #1 D. A. Oeser Farm

National Assoc. Pet. Company

Brunson Drlg. Contractor

Wildcat


Ft. from N. Line

330 Ft. from S. Line

Ft. from E. Line

330 Ft. from W. Line

SW SW NW

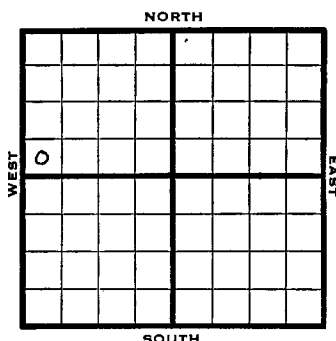

1950 Elev 1801 REPORT

7/19 Spud 7-16-50
8" @ 334
Drlg 1070
8/9 8" @ 334
Top 2528
DST 2655-2703 opn 1 hr rec 120' SW
Heeb 2861 Toronto 2882
Broline' 2930
DST 2972-87 opn 1 hr rec 10' socm
DST 3028-43 opn 1 hr rec 145' mud & wtr
DST 3045-46 rec 60' SW
DST 3086-3132 opn 1 hr rec 6' mud
DST 3129-56 opn 1 hr rec 85' mud
DST 3156-91 opn 1 hr rec 7' mud
Cong 3296 Simp 3340
Arb3349
DST 3353-57 opn 1 hr rec 2345' SW
DST 3370-3421 opn 1 hr rec 2150' wtr
TD 3421
D&A

ABANDONED

KANSAS Ellsworth

Section 21 Township 15 Range 10-W

Well No. #1 D A Oeser

Company National Assoc Pet

