

Map No. JJ Sec. 22 Twp. 15 R. 10W

Well No. 1 Marevak

Brunson Drlg. Company

FIRST REPORT Contractor


SW NW SECTION PLAT

_____ Ft. from N. Line

330 Ft. from S. Line

_____ Ft. from E. Line

330 Ft. from W. Line

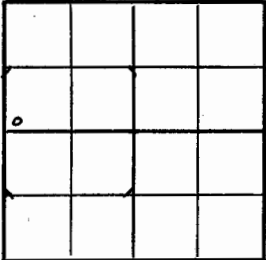

Wildcat

Location X	RECORD	
	Cased _____ in., _____ ft.	
Rig up _____	Sand _____	
Drilling and Remarks:	Gas _____	
	Oil _____	
	Total Depth _____	
	PRODUCTION	
	1st 24 hrs. Nat. _____	
	1st 24 hrs. after shot _____	
	Gas _____ Cu. Ft.	
	Dry Hole _____	
	Abandoned _____	

Date NOV 24 1943 19 S. J. LEWIS Scout

Map No. JJ Sec. 22 Twp. 15 R. 10W

Well No. 1 Marevak

Brunson Drlg. Company

ABANDONED Contractor


SW NW SECTION PLAT

_____ Ft. from N. Line

330 Ft. from S. Line

_____ Ft. from E. Line

330 Ft. from W. Line

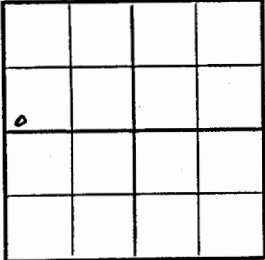

Wildcat

Location _____	RECORD	
	Cased _____ in., _____ ft.	
Rig up _____	Sand _____	
Drilling and Remarks: <i>Cor 3280</i> <i>YD 3290 @ directed</i> <i>Water.</i>	Gas _____	
	Oil _____	
	Total Depth <i>3290</i>	
	PRODUCTION	
	1st 24 hrs. Nat. _____	
	1st 24 hrs. after shot _____	
	Gas _____ Cu. Ft.	
	Dry Hole _____	
	Abandoned _____	

Date MAR 29 1944 19 S. J. LEWIS Scout


KANSAS

Ellsworth

Sec. 22 Twp. 15 R. 10-W

Well No. W1 Marevak Farm

Brunson Drlg. Company

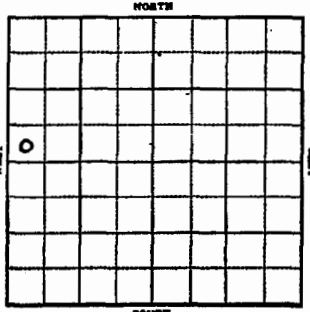

_____ Ft. from N. Line

330 _____ Ft. from S. Line

_____ Ft. from E. Line

330 _____ Ft. from W. Line

Elev. 1761

REPORT

1943	REPORT
11/24	Location.
12/1	Cable rig.
12/8	"
12-15	Spud
12/22	15" @ 323 Drlg. 415
12/29	SD
1944	"
1-5	"
1-12	12" @ 570 Anhy 604 Drlg 612'
1/19	10" @ 612 Drlg. 1800'
1/26	8" @ 1805 TD 2010 UR 8"
2/2	8" @ 1906 Drlg. 2520
2/8	Topeka 2490 7" @ 2760 Drlg. 2765
2/15	2820 Drlg. UR 7"
2/23	7" @ 2862 Lans 2895 Drlg. 2960'

OVER

1944
3/1 Heefner 2790
Lans 2895
BKC 3193
TD 3235
SD for 5"

3/8 "

3/16 5" @ 3234
Cong. 3248
3280 U R 5"

3/22 TD ³²⁹⁰~~3360~~ SD

3/29 Arb 3290
TD 3290
TD 3290 correded
Water.

KANSAS

Ellsworth

FORM 51 5M 1-42 PETROL

Section 22 Township 15 Range 10-W

Well No. #1 Marevak

Company Brunson Drlg.

