

| | | | | |
|--|----------------|-----------------|-------|------------------------|
| County Ellsworth Elev. 1748 | | | | Co. |
| Sec. 32 | Twp. 15 | Rge. 10W | | |
| Company Grant Oil | | | | No. |
| Farm Name John Vacek "B" No. 1 | | | | |
| TOPS | DEPTH | LOG | DATUM | Loc. in Sec. |
| Anh. | | | | SE SE SE |
| Tp. | | | | 200' SL |
| H. | | | | |
| Tr. | | | | |
| Dg. | | | | |
| Bl. | | | | |
| L. | | | | Geol. |
| K.C. | | | | Contr. |
| B.K.C. | | | | B & B Drlg. |
| Ce. | | | | |
| C. | | | | Pool |
| M. | | | | Stoltenberg |
| M. | | | | |
| K. | | | | |
| Mz. | | | | |
| Me. | | | | |
| V. | | | | |
| S. | | | | |
| S. | | | | |
| A. | | | | |
| R. | | | | |
| Pe. | | | | |
| G. | | | | |
| Date Comm. 2-24-56 | | | | No. |
| 8" @ 270/175 drlg. 2235 | | | | |
| FIRST REPORT | | | | No. |
| FEB 29 1956 | | | | |

| | | | | |
|--|----------------|-----------------|-------------|------------------------|
| County Ellsworth Elev. 1748 | | | | Co. |
| Sec. 32 | Twp. 15 | Rge. 10W | | |
| Company Grant Oil | | | | No. |
| Farm Name John Vacek No. 1 | | | | |
| TOPS | DEPTH | LOG | DATUM | Loc. in Sec. |
| Anh. | | | | SE SE SE |
| Tp. | 571 | | | 200' SL |
| H. | 2796 | | | |
| Tr. | 2818 | | | |
| Dg. | | | | |
| Bl. | 2897 | | | |
| L. | 2913 | | 1165 | Geol. |
| K.C. | | | | Contr. |
| B.K.C. | | | | B & B Drlg. |
| Ce. | | | | |
| C. | 3235 | | 1487 | Pool |
| M. | | | | Stoltenberg |
| M. | | | | |
| K. | | | | |
| Mz. | | | | |
| Me. | | | | |
| V. | | | | |
| S. | sh | 3246 | 1498 | |
| S. | sd | 3249 | 1511 | |
| A. | | 3273 | 1525 | |
| R. | | | | |
| Pe. | | | | |
| G. | | | | |
| Date Comm. 2-24-56 | | | | No. |
| 8" @ 270/175 DST 3240-57 open 1 hr. | | | | |
| rec. 275' mco 1035# 5 1/2" @ 3281 | | | | No. |
| CO 20/ 3251-56 S/ 4 boph 4 hr. | | | | |
| Comp. 105 bopd | | | | No. |
| COMPLETE | | | | |
| MAY 1 6 1956 | | | | |

Ellsworth KANSAS

| | | |
|------------|------------|-----------|
| SEC. 32 | TWP. 15 | R. 10W |
|------------|------------|-----------|

WELL NO. #1 John Vacek "B" FARM

COMPANY Grant Oil

CONTRACTOR B & B Drlg.


Stoltenberg

_____ Ft. from N. Line
200 _____ Ft. from S. Line

_____ Ft. from E. Line

_____ Ft. from W. Line

SE SE SE

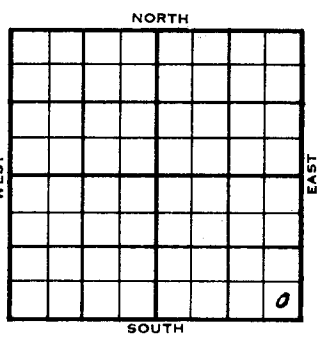

| 1956 | ELEVATION | REPORT |
|------|-----------|--------|
| | 1748' | |

2-29 Comm. 2-24-56
8" @ 270/175
Drlg. 2235

5-16 DST 3240-57 op 1 hr. rec. 275' mco,
1035#
5 1/2" @ 3281,
CO 20/3251-56,
S/ 4 boph, 4 hrs.
Comp. 105 bopd
Anh. 571, H. 2796', Tr. 2818',
BL. 2897', L. 2913', C.Lm. 3235',
S.Sh. 3246', S. Sd. 3249', A. 3273'.
TD 3282'

COMPLETED

DX 78-1

Ellsworth KANSAS

Section 32 Township 15 Range 10 W

Well No. #1 John Vacek "B"

Company Grant Oil

