

Map No. 55 Sec. 33 Twp. 15 R. 10WWell No. 1-CharvatAnnunzio et al Company

Contractor

## SECTION PLAT

|  |  |   |  |
|--|--|---|--|
|  |  | 0 |  |
|  |  |   |  |
|  |  |   |  |
|  |  |   |  |
|  |  |   |  |

330 Ft. from N. Line

\_\_\_\_\_ Ft. from S. Line

\_\_\_\_\_ Ft. from E. Line

990 Ft. from W. Line

## FIRST REPORTS

Location \_\_\_\_\_

Rig up \_\_\_\_\_

Drilling and Remarks:

ROG

## RECORD

Cased \_\_\_\_\_ in., \_\_\_\_\_ ft.

Sand \_\_\_\_\_

Gas \_\_\_\_\_

Oil \_\_\_\_\_

Total Depth \_\_\_\_\_

## PRODUCTION

1st 24 hrs. Nat. \_\_\_\_\_

1st 24 hrs. after shot \_\_\_\_\_

Gas \_\_\_\_\_ Cu. Ft.

Dry Hole \_\_\_\_\_

Abandoned \_\_\_\_\_

Date

9-19-34 19ORVAL MANNSCHRECK  
ScoutMap No. 55 Sec. 33 Twp. 15 R. 10WWell No. 1-CharvatAnnunzio et al Company

Contractor

## ABANDONED

## SECTION PLAT

|  |  |   |  |
|--|--|---|--|
|  |  | 0 |  |
|  |  |   |  |
|  |  |   |  |
|  |  |   |  |
|  |  |   |  |

330 Ft. from N. Line

\_\_\_\_\_ Ft. from S. Line

\_\_\_\_\_ Ft. from E. Line

990 Ft. from W. Line

Location \_\_\_\_\_

Rig up \_\_\_\_\_

Drilling and Remarks:

HFWNVA

## RECORD

Cased \_\_\_\_\_ in., \_\_\_\_\_ ft.

Sand siliceous 3318

Gas \_\_\_\_\_

Oil \_\_\_\_\_

Total Depth 3323

## PRODUCTION

1st 24 hrs. Nat. \_\_\_\_\_

1st 24 hrs. after shot \_\_\_\_\_

Gas \_\_\_\_\_ Cu. Ft.

Dry Hole \_\_\_\_\_

Abandoned \_\_\_\_\_

Date

11-27-34 192ORVAL MANNSCHRECK  
Scout

Ellsworth


Map No. KANSAS Sec. 33 Twp. 15 R. 10<sup>W</sup>  
Well No. 1 Chawat Farm  
Ainsworth et al Company

330 Ft. from N. Line

Ft. from S. Line

Ft. from E. Line

990 Ft. from W. Line

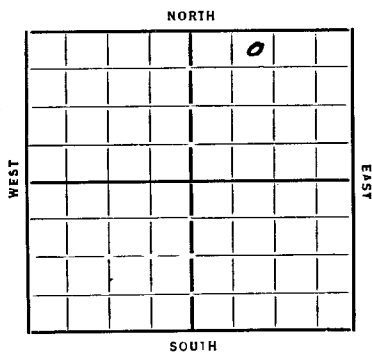

## REPORT

| REPORT |                                |
|--------|--------------------------------|
| 9/19   | Ros                            |
| 9/27   | Rlgw                           |
| 10/4   |                                |
| 10/11  | Spudking                       |
| 10/18  | 545 W R 15"                    |
| 10/25  | Oly 1235 Salt 955              |
| 11/1   | " 1810 Ankerplate 540 13" 1277 |
| 11/8   | " 2307 10" 1850                |
| 11/15  | 8" 2795 Rep. Motor             |
| 11/22  | Viola 3212 6" 3242 Oly 3262    |
| 11/27  | Siliceous 3318 T 1) 3323       |
|        | HFW 1) 5 A                     |

# ABANDONED

# RECORD


Cased \_\_\_\_\_ in. \_\_\_\_\_ ft.  
Sand \_\_\_\_\_  
Gas \_\_\_\_\_  
Oil \_\_\_\_\_  
Total Depth \_\_\_\_\_

## PRODUCTION

1st 24 hrs. Nat. \_\_\_\_\_  
1st 24 hrs. after shot \_\_\_\_\_  
Gas \_\_\_\_\_ cu. ft. \_\_\_\_\_  
Dry Hole \_\_\_\_\_  
Abandoned \_\_\_\_\_

Ellsworth

Map No. KANSAS Sec. 33 Twp. 15 R. 10  
Well No. 1 Charvat Farm  
dineworth et al Company

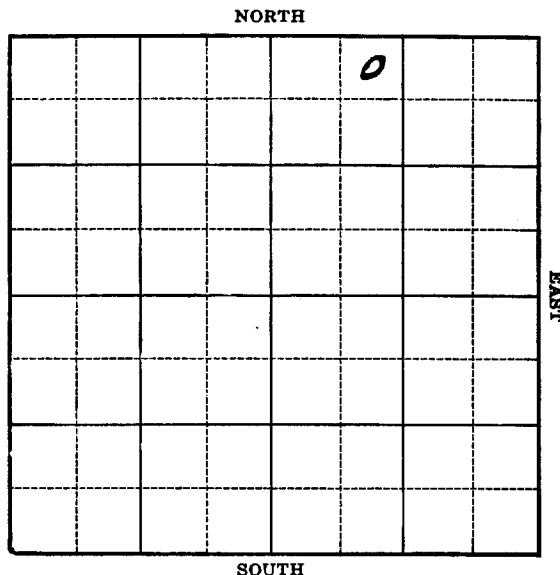

Location \_\_\_\_\_  
Drilling Remarks \_\_\_\_\_

Rig Up \_\_\_\_\_  
Drilling Remarks

This image shows a single page of white paper with horizontal blue or grey ruling lines. The lines are evenly spaced and run across the width of the page. There is no handwriting or printed text on the page.