

55 KANSAS

Ellsworth

Map No. Sec. 31 Twp. 15 R. 10 W

Well No. 1 Claussen

Tom Johnson & Vickers Pet. Co. Company

Contractor

FIRST RECORD

SECTION PLAT

	0		

Ft. from N. Line

660 Ft. from S. Line

660 Ft. from E. Line

Ft. from W. Line

Location

Rig up

Drilling and Remarks:

RECORD

Cased in., ft.

Sand

Gas

Oil

Total Depth

PRODUCTION

1st 24 hrs. Nat.

1st 24 hrs. after shot

Gas Cu. Ft.

Dry Hole

Abandoned

Date

APR 1 1932 CHAS. L. SHERWOOD Scout

55 KANSAS

Ellsworth

Map No. Sec. 31 Twp. 15 R. 10 W

Well No. 1 Claussen

Tom Johnson & Vickers Pet. Co. Company

Contractor

CONCEPTE

SECTION PLAT

	0		

Ft. from N. Line

660 Ft. from S. Line

660 Ft. from E. Line

Ft. from W. Line

ABANDONED

Location

Rig up

Drilling and Remarks:

Top Log 3300

Dilicams 3364-73

HFW

D & A 3373

RECORD

Cased 6 in., 3367 ft.

Sand

Gas

Oil

Total Depth 3373

PRODUCTION

1st 24 hrs. Nat.

1st 24 hrs. after shot

Gas Cu. Ft.

Dry Hole ✓

Abandoned ✓

Date

JUL 1 1932 CHAS. L. SHERWOOD Scout

Ollsworth
FORM 232A-SM-6-30-PETROL

Map No. KANSAS Sec. 31 Twp. 15 R. 10^w

Well No. 1 - Claussen Farm


Tom Johnson's Vickers Pet Company

 Ft. from N. Line

660 Ft. from S. Line

660 Ft. from E. Line

 Ft. from W. Line

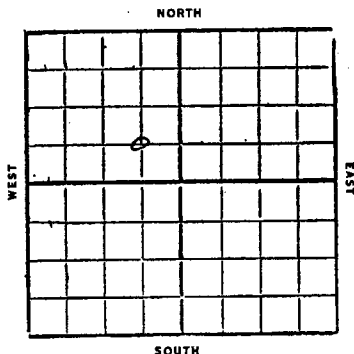

1932

Date	REPORT
4/20	Cellar
4/27	Moving in material
5/14	Drdg
5/11	20"-245'
	Drldg 550'
5/18	12"-1050'
	Drldg 1450'
5/25	10"-1960' Cldg out
6/1	UIR 10"-2300'
6/8	TD 2330' UIR 10'
6/15	Drldg 2750'
6/22	8"-2903'
	Drldg 3075'
6/29	Top Cong 3300'
	show oil 3319'
	Ang 6'
7/6	6"-3362'
	Top Silic 3364-73' HFW
	SD 3373 orders
	(over)

7/13 - Cased 6"-3362'
Top Cong 3300'
Silicious 3364-73'
HFW
TD 3373
Abandoned

