

County Ellsworth Elev. _____
 Sec. 31 Twp. 15 Rge. LOW
 Company Shields Oil Prod.
 FarmName Nedjl No. 1

TOPS	DEPTH	LOG	DATUM	Loc. in Sec.
Anh.				NE SE NE
Tr.				
Dg.				
Bl.				
L.				Geol.
K.C.				Contr.
B.K.C.				Co. tools
Ce.				
M.				Vacek
K.				
Mz.				
Me.				
V.				
S.				
S.				
A.				
R.				
PC.				
G.				
TD.				JUL 6 '55

Date Comm. 7-5-55

T. _____
 R. _____

County Ellsworth Elev. 1757 DF
 Sec. 31 Twp. 15 Rge. LOW
 Company Shields Oil Prod.
 FarmName Nedjl No. 1

TOPS	DEPTH	LOG	DATUM	Loc. in Sec.
Anh.				NE SE NE
Tr.				
Dg.				
Bl.				
L.				Geol.
K.C.				Contr.
B.K.C.				Co. tools
Ce.				
M.				Vacek
K.				
Mz.				
Me.				
V.				
S.				
S.				
A.				
R.				
PC.				
G.				
TD.				3241

Date Comm. 7-5-55 AUG 3 1955

8 5/8" @ 368/200 DST 3242-45
 open 2 hr. Rec. 40' oil 20' ocm
 482/20" 5 1/2" @ 3242/75 CO to 3245
 FU 80' oil 12 hr. B/ 4 go 1 hr.
 500 A DD 3246 1000 A HFW

D & A

T. _____
 R. _____

KANSAS

Ellsworth

SEC. 31 TWP. 15 R. 10W

WELL NO. #1 Nedjl FARM

COMPANY Shields Oil Prod.

CONTRACTOR Co. Tools


Vacek

_____ Ft. from N. Line

_____ Ft. from S. Line

_____ Ft. from E. Line

_____ Ft. from W. Line

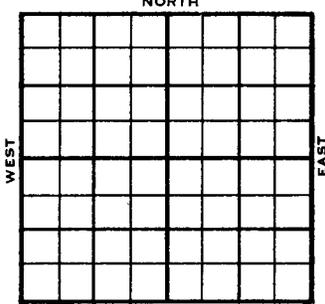

1955 ELEVATION REPORT 1759 RB 1757 DF

7/6 Comm. 7-5-55

8/3 Comm 7-5-55
 Tr Dodge 2824,
 Dg 2840
 L 2901
 A 3241
 TD 3245
 8 5/8" @ 368/200 DST 3242-45
 open 2 hr. Rec 40' oil 20' ocm
 482/20" 5 1/2" @ 3242/75 CO to 3245
 FU 80' oil 12 hr. B/4 go 1 hr.
 500 A DD 3246 1000 A HFW
 D & A

ABANDONED

DX-78

DX 78-1 Ellsworth KANSAS

Section 31 Township 15 Range 10W

Well No. 1 Nedjl

Company Shields Oil Prod.

