


Ellsworth
 Map No. 55 Sec. 31 Twp. 15 R. 10W
 Well No. 1- Raze
Equity Gas etal Company
 Contractor

FIRST REPORT

330 Ft. from N. Line
 _____ Ft. from S. Line
330 Ft. from E. Line
 _____ Ft. from W. Line

SECTION PLAT

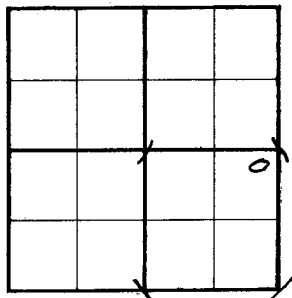

Location _____

Rig up _____

Drilling and Remarks:

RECORD

Cased _____ in., _____ ft.

Sand _____

Gas _____

Oil _____

Total Depth _____

PRODUCTION

1st 24 hrs. Nat. _____

1st 24 hrs. after shot _____

Gas _____ Cu. Ft.

Dry Hole _____

Abandoned _____

Date


JUL 14 1937 19 _____ H. D. Hatfield Scout

Ellsworth
 Map No. 55 Sec. 31 Twp. 15 R. 10W
 Well No. 1- Raze
Equity Gas etal Company
 Contractor

KANSAS

SECTION PLAT

330 Ft. from N. Line
 _____ Ft. from S. Line
330 Ft. from E. Line
 _____ Ft. from W. Line

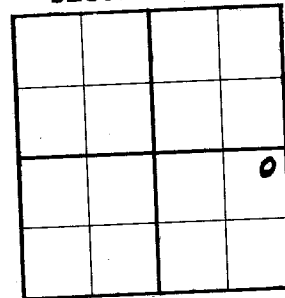

ABANDONED

Location _____

Rig up _____

Drilling and Remarks:

H. F. WU + H

RECORD

Cased _____ in., _____ ft.

Sand 3253

Gas _____

Oil _____

Total Depth 3270

PRODUCTION

1st 24 hrs. Nat. _____

1st 24 hrs. after shot _____

Gas _____ Cu. Ft.

Dry Hole _____

Abandoned _____


Date

SEP 22 1937 19 _____ H. D. Hatfield Scout

KANSAS Ellsworth

Sec. 31 Twp. 15 R. 10-WWell No. #1 Rozac FarmEquity Gas et al Company330 Ft. from N. Line Ft. from S. Line330 Ft. from E. Line Ft. from W. Line

Elev. 1769

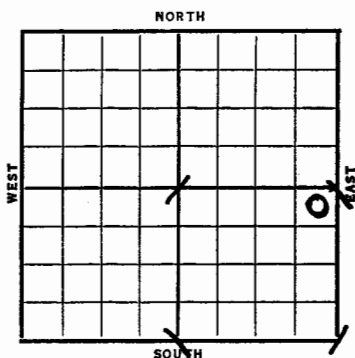

Date	REPORT
1937	
7/14	15" @ 323'. 12" @ 490'. 10" @ 810' T.D. Pulled in rig. SD for repairs.
7/23	" " " "
7/30	T.D. 1840'. C.O.j
8/6	T.D. 2110' C.O.
8/13	8" @ 2260'. SD for repairs.
8/20	8" @ 2301'. Drlg. 2340'.
8/28	Drlg. 2810'.
9/3	6" @ 2820'. 3 BW 2851-57'. K.C. 2898'. S.O. 2898-3000 T.D. 3002' Fsg.
9/10	T.D. 3002'. U.R. 7".
9/17	7" @ 2971'. C.O.
9/22	Sil. 3253'. T.D. 3270'. H.F.W.
	ABANDONED

Ellsworth

KANSAS

Section 31 Township 15 Range 10-WWell Number 1 - RozacCompany Equity Gas et al