

Kansas

Map No. _____ Sec. 31 Twp. 15 R. 10W

Well No. 1 Razec

_____Brunson Drlg._____
Company

_____Brunson Drlg._____
Contractor

SE SE SE

SECTION PLAT

_____Ft. from N. Line

330 Ft. from S. Line

330 Ft. from E. Line

_____Ft. from W. Line



Ellsworth County

Location X

Rig up _____

Drilling and Remarks: _____

RECORD

Cased _____ in., _____ ft.

Sand _____

Gas _____

Oil _____

Total Depth _____

PRODUCTION

1st 24 hrs. Nat. _____

1st 24 hrs. after shot _____

Gas _____ Cu. Ft.

Dry Hole _____

Abandoned _____

Date

JUN 28 1950 19 J. E. TYRA Scout

Kansas

Map No. _____ Sec. 31 Twp. 15 R. 10W

Well No. 1 Razec

_____Brunson Drlg._____
Company

_____Brunson Drlg._____
Contractor

SE SE SE


E1. 1822
SECTION PLAT

_____Ft. from N. Line

330 Ft. from S. Line

330 Ft. from E. Line

_____Ft. from W. Line

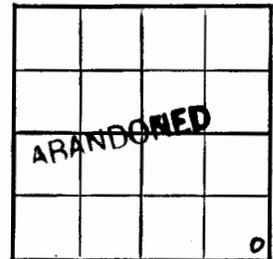

Ellsworth County

Location _____

Rig up _____

Drilling and Remarks: _____

RECORD

Cased _____ in., _____ ft.

Sand _____

Gas _____

Oil _____

Total Depth 3345

PRODUCTION

1st 24 hrs. Nat. _____

1st 24 hrs. after shot _____

Gas _____ Cu. Ft.

Dry Hole _____

Abandoned _____

Date


JUL 29 1950 19 J. E. TYRA Scout

Ellsworth **KANSAS**
10W ✓

Sec. 31 Twp. 15 R. 10W

Well No. #1 Razec Farm
Brunson Drlg. Company
Brunson Drlg. Contractor

_____ Ft. from N. Line
330' Ft. from S. Line
330' Ft. from E. Line
_____ Ft. from W. Line
SE SE SE

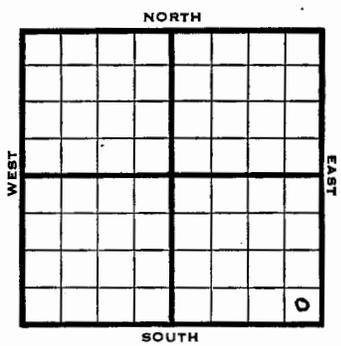

1950 **Elev 1822** REPORT

6/28 Location
7/19 8" @ 310
Lans 2960 Arb 3315-45 TD
TD 3345
D&A
ABANDONED

Section 31 Township 15 Range 10-W

Well No. #1 Razec
Company Brunson Drlg.

