

KANSAS

Kansas Pool Name Vacek

Map No. 55 Sec. 32 Twp. 15 R. 10W

Well No. 1 Zvolanek "B"

Cities Service Company

FIRST REPORT Contractor

SW NE


SECTION PLAT

 Ft. from N. Line

330 Ft. from S. Line

 Ft. from E. Line

330 Ft. from W. Line

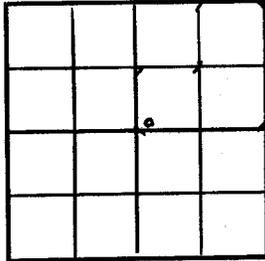

Ellsworth County

Location

Rig up

Drilling and Remarks:

R U R

RECORD

Cased in., ft.

Sand

Gas

Oil

Total Depth

PRODUCTION

1st 24 hrs. Nat.

1st 24 hrs. after shot

Gas Cu. Ft.

Dry Hole

Abandoned

Date

APR 24 1946 19 S. J. LEWIS Scout

KANSAS

Kansas Pool Name Vacek Pool

Map No. 55 Sec. 32 Twp. 15 R. 10W

Well No. 1 Zvolanek "B"

Cities Service Company

ABANDONED Contractor

SW NE


E11804
SECTION PLAT

 Ft. from N. Line

330 Ft. from S. Line

 Ft. from E. Line

330 Ft. from W. Line

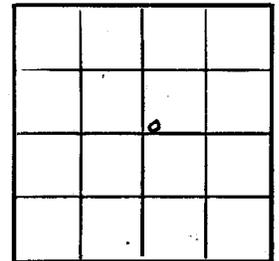

correct!
ELLSWORTH
~~Russell~~ County

Location

Rig up

Drilling and Remarks:

Correct 3305
5" @ 3306

RECORD

Cased in., ft.

Sand

Gas

Oil

Total Depth 3312

PRODUCTION

1st 24 hrs. Nat.

1st 24 hrs. after shot

Gas Cu. Ft.

Dry Hole

Abandoned

Date

AUG 28 1946 19 S. J. LEWIS Scout

KANSAS

Ellsworth County

Sec. 32 Twp. 15 R. 10W

Well No. #1 Zvolanek "B" Farm

Cities Service Company


Vacek

_____ Ft. from N. Line

330 Ft. from S. Line

_____ Ft. from E. Line

330 Ft. from W. Line

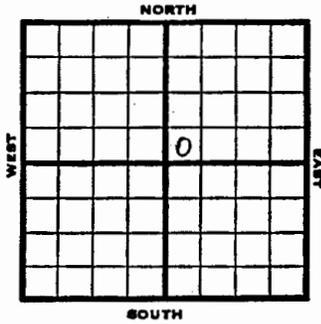

SW NE

1946

8/28 Arb 3305'
5" @ 3306'
TD 3312'

ABANDONED

1946	REPORT		
	Elev. 1804'		
4/24	RUR		
5/1	8" @ 420		
	Drlg 1350'		
5/7	Drlg 2890'		
5/14	Lans 2947		
	Simp 3285		
	Arb 3303-04 TD		
	5" @ 3304 RU?ST		
5/21	" " "		
5/29	Arb. 3305		
	5" @ 3306 corrected.		
	TD 3312		
	Pumped 34 oil plus 10 wtr. in 24 hrs.		
6/5	1000 acid.		
	Pump 16 oil plus 7W PH 24 hrs.		
6/12	" " "		
6/22	" " "		
6/26	" " "		
7/3	" " "		
7/9	" " "		
7/16	" " "		
7/23	" " "		
7/30	" " "		
8/6	" " "		
8/13	" " "		
8/20	" " "		

OVER

Section 32 Township 15 Range 10W

Well No. #1, Zvolanek "B"

Company Cities Service

