

County **Ellsworth** State **Kansas**
 Sec. **32** (Blk. Twp.) **16** (Sur. Rge.) **10W** Map No.
 Operator **Cities Service**
 Well No. **3** Farm **Zvolanek**
 Elev. _____ Location **C S L SW NW**

330 Ft. From **S** Line **NW**
660 Ft. From **W** Line **Quarter**
 Ist. Report **APR 4 1951**
 Completion _____
 Remarks _____
 Spudding Date _____

Drlg. Data

Location

J. E. TYRA

County **Ellsworth** State **Kansas**
 Sec. **32** (Blk. Twp.) **15** (Sur. Rge.) **10W** Map No.
 Operator **Cities Service**
 Well No. **3** Farm **Zvolanek**
 Elev. **1769** Location **C S L SW NW**

330 Ft. From **S** Line **NW**
660 Ft. From **W** Line **Quarter**
 Ist. Report _____
 Completion **MAY 16 1951**
 Remarks _____
 Spudding Date **4-9-51**

Drlg. Data Oil well TD 3260

8" @ 417 Lans. 2910 Arb. 3248

5" @ 3249 TD 3257 FU 440' oil 14 hr.

500 A 1500 A P/ 10 bopd DD 3260

FU 1200' oil 37 hr. Comp. 50 bopd

J. E. TYRA

Ellsworth KANSAS

Sec. 32 Twp. 15 R. 10W ✓

Well No. #3 Zvolanek Farm

Cities Service Company

Contractor


Ft. from N. Line

330' Ft. from S. Line

Ft. from E. Line

660' Ft. from W. Line

C S L SW NW

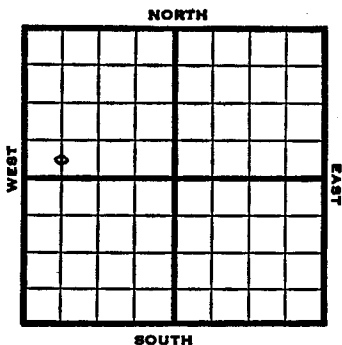

1951 Elev. 1769' REPORT

4/4 Location

5/16 Spud 4-9-51

Oil well TD 3260' 8" ● 417'

Lans. 2910' Arb. 3248'

5" ● 3249' TD 3257' FU 440' oil

14 hr. 500 A 1500 A

P/10 BOPD DD 3260' FU 1200' oil

37 hr.

Comp. 50 BOPD

COMPLETED

Section 32 Township 15 Range 10W

Well No. #3 Zvolanek

Company Cities Service

